

### PROPOSED CHANGE NO. 042

Page 1 of 17

Contractor: Tradition Construction Inc. Date: October 1, 2024

Reason for Owner Request Project Name: Coldstream Municipal Office

Change: Addition and Renovation

Project No.: RFT-CMS-2023-01;

+VG #22281

Pursuant to paragraph 6.2.1 of GC 6.2 - CHANGE ORDER in CCDC 2 - 2020, indicate within \_\_\_\_\_ days of the above date the changes to the *Contract Price* and *Contract Time* for the following proposed change in the *Work*. Provide appropriate labour and material breakdown in parts of the work indicating credits and/or extras; meanwhile, ensure that no further work is done which might be affected if the change hereby contemplated, should be ordered. Do **not** proceed with the change without a *Change Order* or *Change Directive* authorizing a change in the *Work*.

### Description:

- 1. To remove existing wall tile and patch & repair walls as required to receive new finishes as per enclosed drawing AR-47 & AR-52. Provide laminated gypsum board & tile backer board at existing block walls as per enclosed drawing AR-47.
- 2. To remove existing floor finish & make good existing subfloor to receive new floor finish as per enclosed drawing AR-47 & AR-51.
- 3. To remove and replace existing washroom partitions as per enclosed drawing AR-47. New washroom partitions to be Hadrian Phenolic Elite Max Series, 92" in 317 Field Elm.
- 4. To remove existing acoustic ceiling and install new acoustic ceiling grid & tiles as per enclosed drawing AR-48.
- 5. To remove existing washroom accessories & turn over to owner.
- 6. To paint existing door & frame as per enclosed drawing AR-47.
- 7. To provide solid surface countertop with P.Lam gables as per enclosed drawings AR-49 & AR-50.
- 8. To remove & replace existing plumbing fixtures & ceiling diffusers as per enclosed CCO-ME-14, authored by Vanderwesten & Rutherford Associates Inc.
- 9. To remove & replace existing light fixtures as per enclosed CCO-ME-14, authored by Vanderwesten & Rutherford Associates Inc.

Prepared by the Contract Administration Director	

Scott Elliott October 1, 2024

Name and Title of Person Signing Signature Date


Distributed to: Client X Struct. 

Mech. & Elect. X Chief Bldg. Official 

Other

K:\TVG-Brantford\Coldstream Municipal Office-22281\Contract Admin\PCN\PCN#042 - Renovation of Existing Washrooms\PCN#042 - Renovation of Existing Washrooms.docx

This communication is intended as a private communication for the sole use of the primary addressee and those individuals listed for copies in the original message. The information contained in this communication is private and confidential and if you are not an original intended recipient you are hereby notified that copying, forwarding or other dissemination or distribution of this communication by any means is prohibited. If you are not specifically authorized to receive this communication and if you believe that you received it in error, please notify the original sender immediately. This is proprietary to +VG Architects (The Ventin Group).

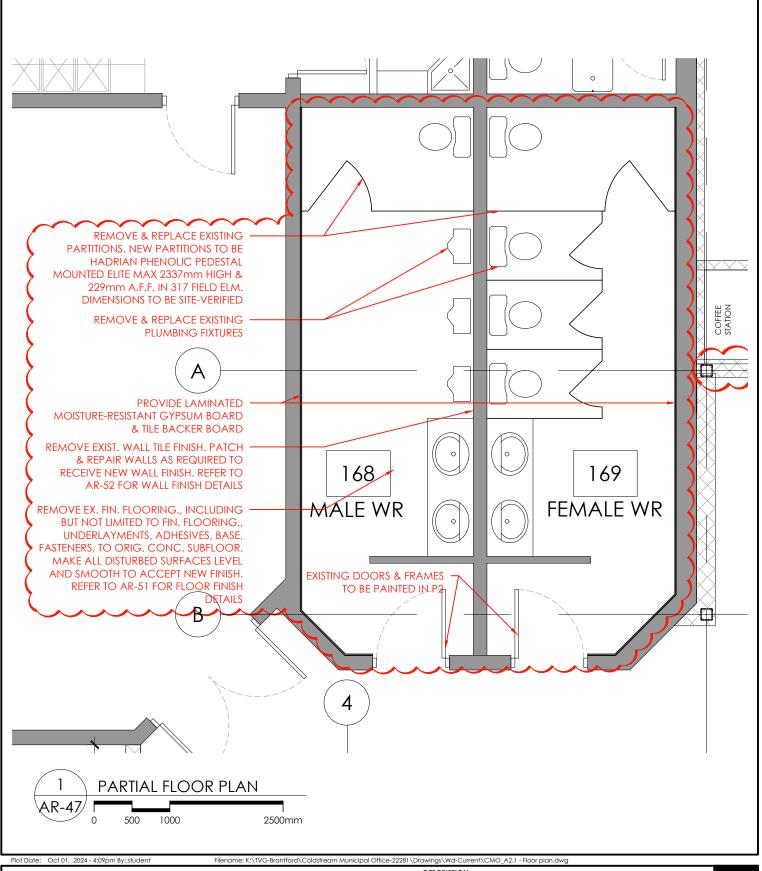





#### DESCRIPTION:

DRAWN BY:


### FLOOR PLAN - EXISTING WASHROOM RENOVATION

DATE:	2024.09.30	SCALE:	1:50
DWG. REF. NO.:	A2.1	ISSUED FOR:	PCN#042

PROJECT NO: 22281

**COLDSTREAM MUNICIPAL OFFICE** 

IV

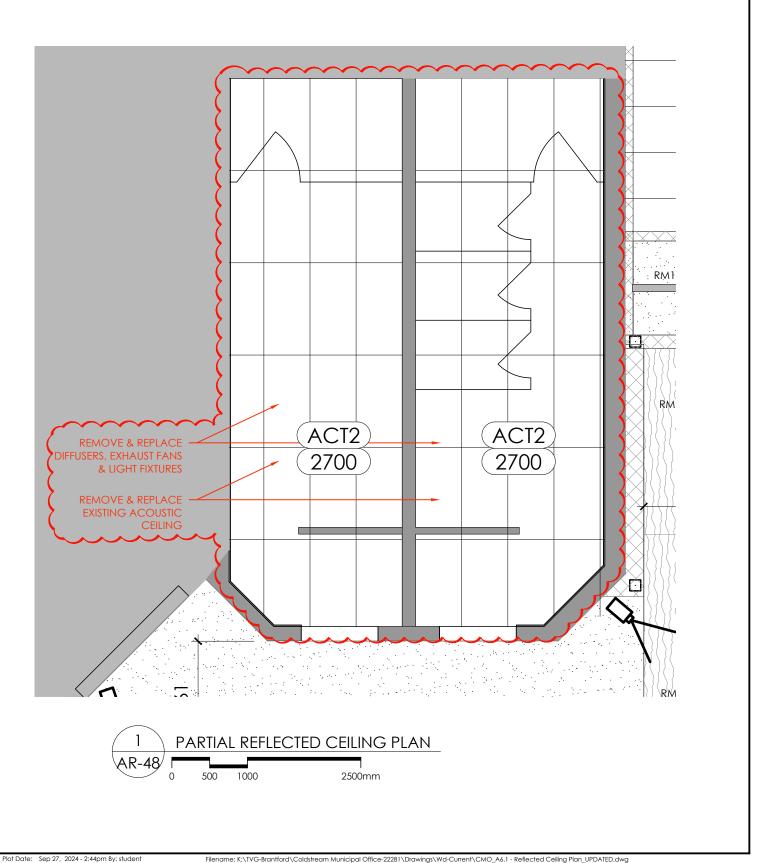

Filename: K:\TVG-Brantford\Coldstream Municipal Office-22281\Drawings\Wd-Current\CMO\_A6.1 - Reflected Ceiling Plan\_UPDATED.dwg






#### DESCRIPTION: **RCP - EXISTING WASHROOM RENOVATION**

DATE:	2024.09.30	SCALE:	1:50
DWG. REF. NO.:	A6.1	ISSUED FOR:	PCN#042

22281 PROJECT NO:

**COLDSTREAM MUNICIPAL OFFICE** CHECKED BY: SE

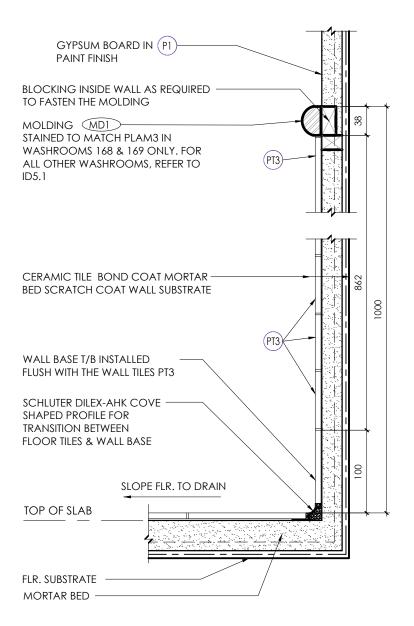



Plot Date: Sep 27, 2024 - 2:47pm By: student

Filename: K:\TVG-Brantford\Coldstream Municipal Office-22281\Drawings\Wd-Current\CMO\_A7.0 - Washroom Details \_ UPDATED.dwg







#### DESCRIPTION: TYP. WALL TILING SECTION DETAIL AT WASHROOMS

DATE:	2024.09.30	SCALE:	1:5
DWG. REF. NO.:	9/A7.0	ISSUED FOR:	PCN#042
	00001		


PROJECT NO: 22281

**COLDSTREAM MUNICIPAL OFFICE** 

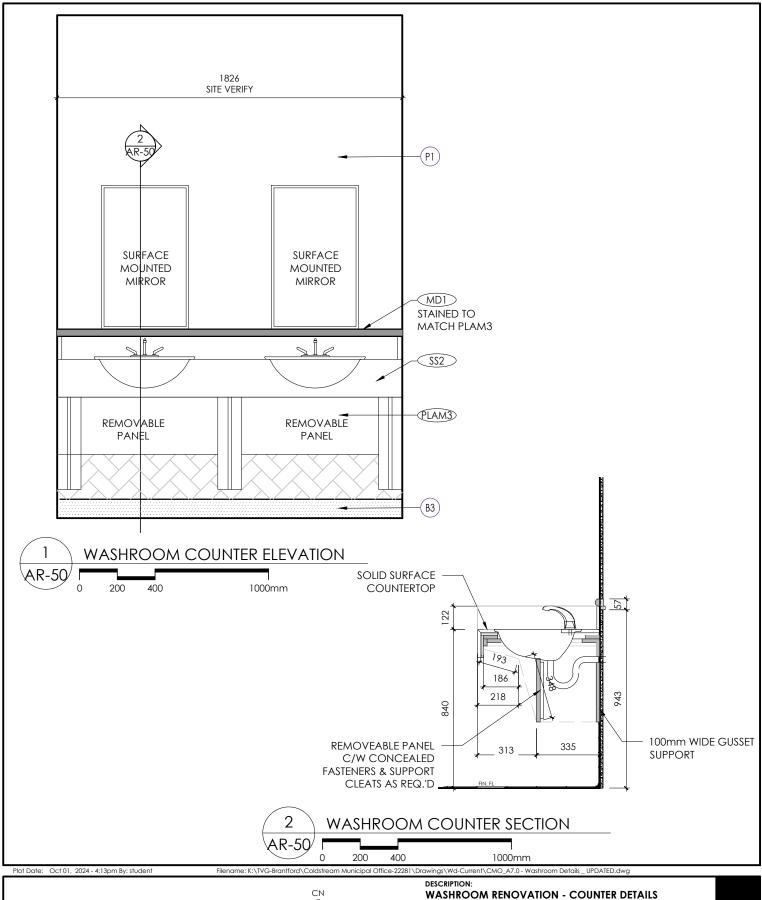

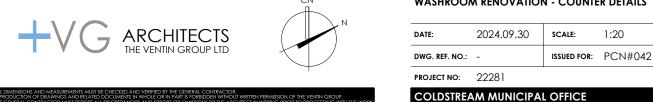

CHECKED BY: SE

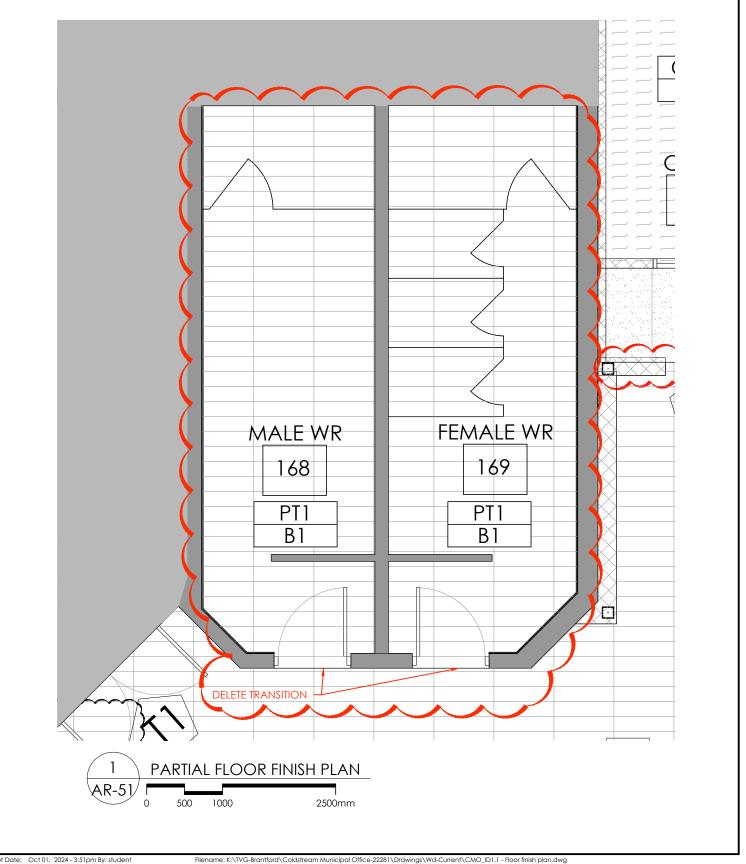

Plot Date: Oct 01, 2024 - 3:51pm By: student






### FLOOR FINISHES AT EXISTING WASHROOMS

DATE:	2024.10.01	SCALE:	1:50
DWG. REF. NO.:	ID1.1	ISSUED FOR:	PCN#042

PROJECT NO: 22281

**COLDSTREAM MUNICIPAL OFFICE** 

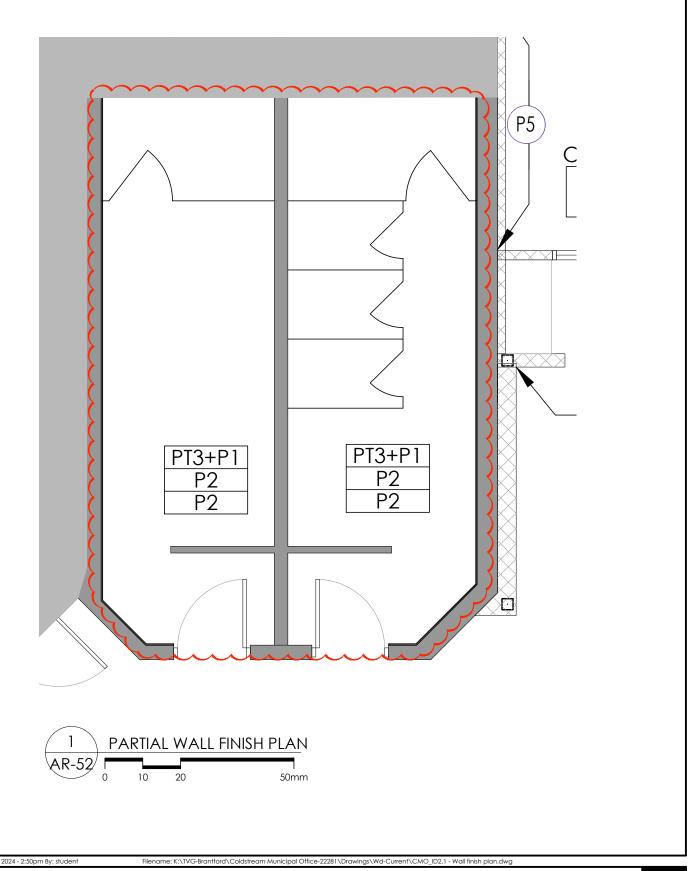





#### DESCRIPTION: EXISTING WASHROOMS RENOVATION - WALL **FINISHES**

DATE:	2024.09.30	SCALE:	1:50
DWG. REF. NO.:	ID2.1	ISSUED FOR:	PCN#042

PROJECT NO: 22281

**COLDSTREAM MUNICIPAL OFFICE** 

DRAWN BY: LV CHECKED BY: SE

### CONTEMPLATED CHANGE ORDER

**ME-14** 

Prime +VG Architects – The Ventin Group Ltd. Contractor: Tradition Construction Inc.

Project: Coldstream Municipal Office Project No.: 23-006

Date Issued: October 1, 2024 Issued By: R. Raycraft

Pursuant to the requirements of General Condition GC 6.2 - Change Order in CCDC 2-2008 as amended, indicate within 10 days of the date of issue the changes to the Contract Price and Contract Time for the following proposed change in the Work. Do not proceed with the change to the Work without a Change Order or Change Directive authorizing the change in the Work.

#### Title:

#### 1.1 CCO-ME-14 Washrooms 168 & 169 Refresh

#### References:

2.1 Contract Drawings M1.1, M2.1, M3.0, M4.0, E1.1, E2.1 & E3.1

#### Description:

- 3.1 Refer to Drawing <u>M1.1 Ground Floor Plan Plumbing Demolition</u>
  - .1 Refer to revised drawing M1.1.1 included herewith.
  - .2 Remove plumbing fixtures.
  - .3 Remove floor drain strainers.
- 3.2 Refer to Drawing <u>M2.1 Ground Floor Plan Plumbing New</u>
  - .1 Refer to revised drawing M2.1.5 included herewith.
  - .2 Add new water closets (W2).
  - .3 Add new urinal (U1).
    - 1. Bowl: American standard Maybrook 6581.001.
    - 2. Flush Valve: Delta Commercial 81T201.
    - 3. Carrier: reuse existing if possible.
  - .4 Add new Drinking Fountain (DF).
    - 1. Fountain: Elkay VRCDMWSK c/w manufactures wall carrier.
    - 2. Supplies: McGuire #HST11LK.
  - .5 Add new floor drain strainer, match existing manufacture.
- 3.3 Refer to Drawing <u>M3.0 Ground Plan and Roof Plan HVAC Demolition</u>
  - 1 Refer to revised drawing M3.0.2 included herewith.
  - .2 Remove the existing exhaust grille of the existing exhaust fan in the 168 WR and 169 WR.
  - .3 Remove the existing electrical baseboard in the 168 WR and 169 WR.
- 3.4 Refer to Drawing <u>M4.0 Ground Floor Plan HVAC New</u>
  - .1 Refer to revised drawing M4.0.7 included herewith.
  - .2 Add new exhaust grille of the existing exhaust fan in the 168 WR and 169 WR.
  - .3 Add new electrical baseboard in the 168 WR and 169 WR.

Version 1: 2017 Page 1 of 2

### CONTEMPLATED CHANGE ORDER

**ME-14** 

Prime +VG Architects – The Ventin Group Ltd. Contractor: Tradition Construction Inc.

Project: Coldstream Municipal Office Project No.: 23-006

Date Issued: October 1, 2024 Issued By: R. Raycraft


Pursuant to the requirements of General Condition GC 6.2 - Change Order in CCDC 2-2008 as amended, indicate within 10 days of the date of issue the changes to the Contract Price and Contract Time for the following proposed change in the Work. Do not proceed with the change to the Work without a Change Order or Change Directive authorizing the change in the Work.


- 3.5 Refer to Drawing E1.1 Ground Floor Plan Demolition
  - .1 Refer to revised drawing E1.1.4 included herewith.
  - .2 Remove electrical equipment and fixtures in 168 WR and 169 WR.
- 3.6 Refer to Drawing <u>E2.1 Ground Floor Plan Lighting</u>
  - .1 Refer to revised drawing E2.1.7 included herewith.
  - .2 Add new light fixtures and associated light switches and occupancy sensors.
- 3.7 Refer to Drawing E2.1 Ground Floor Plan Lighting
  - .1 Refer to revised drawing E3.1.4 included herewith.
  - .2 Add new baseboard heaters.
  - .3 Revise electric heat schedule.

### Reason for Change:

4.1 Owner's Request

Version 1: 2017 Page 2 of 2

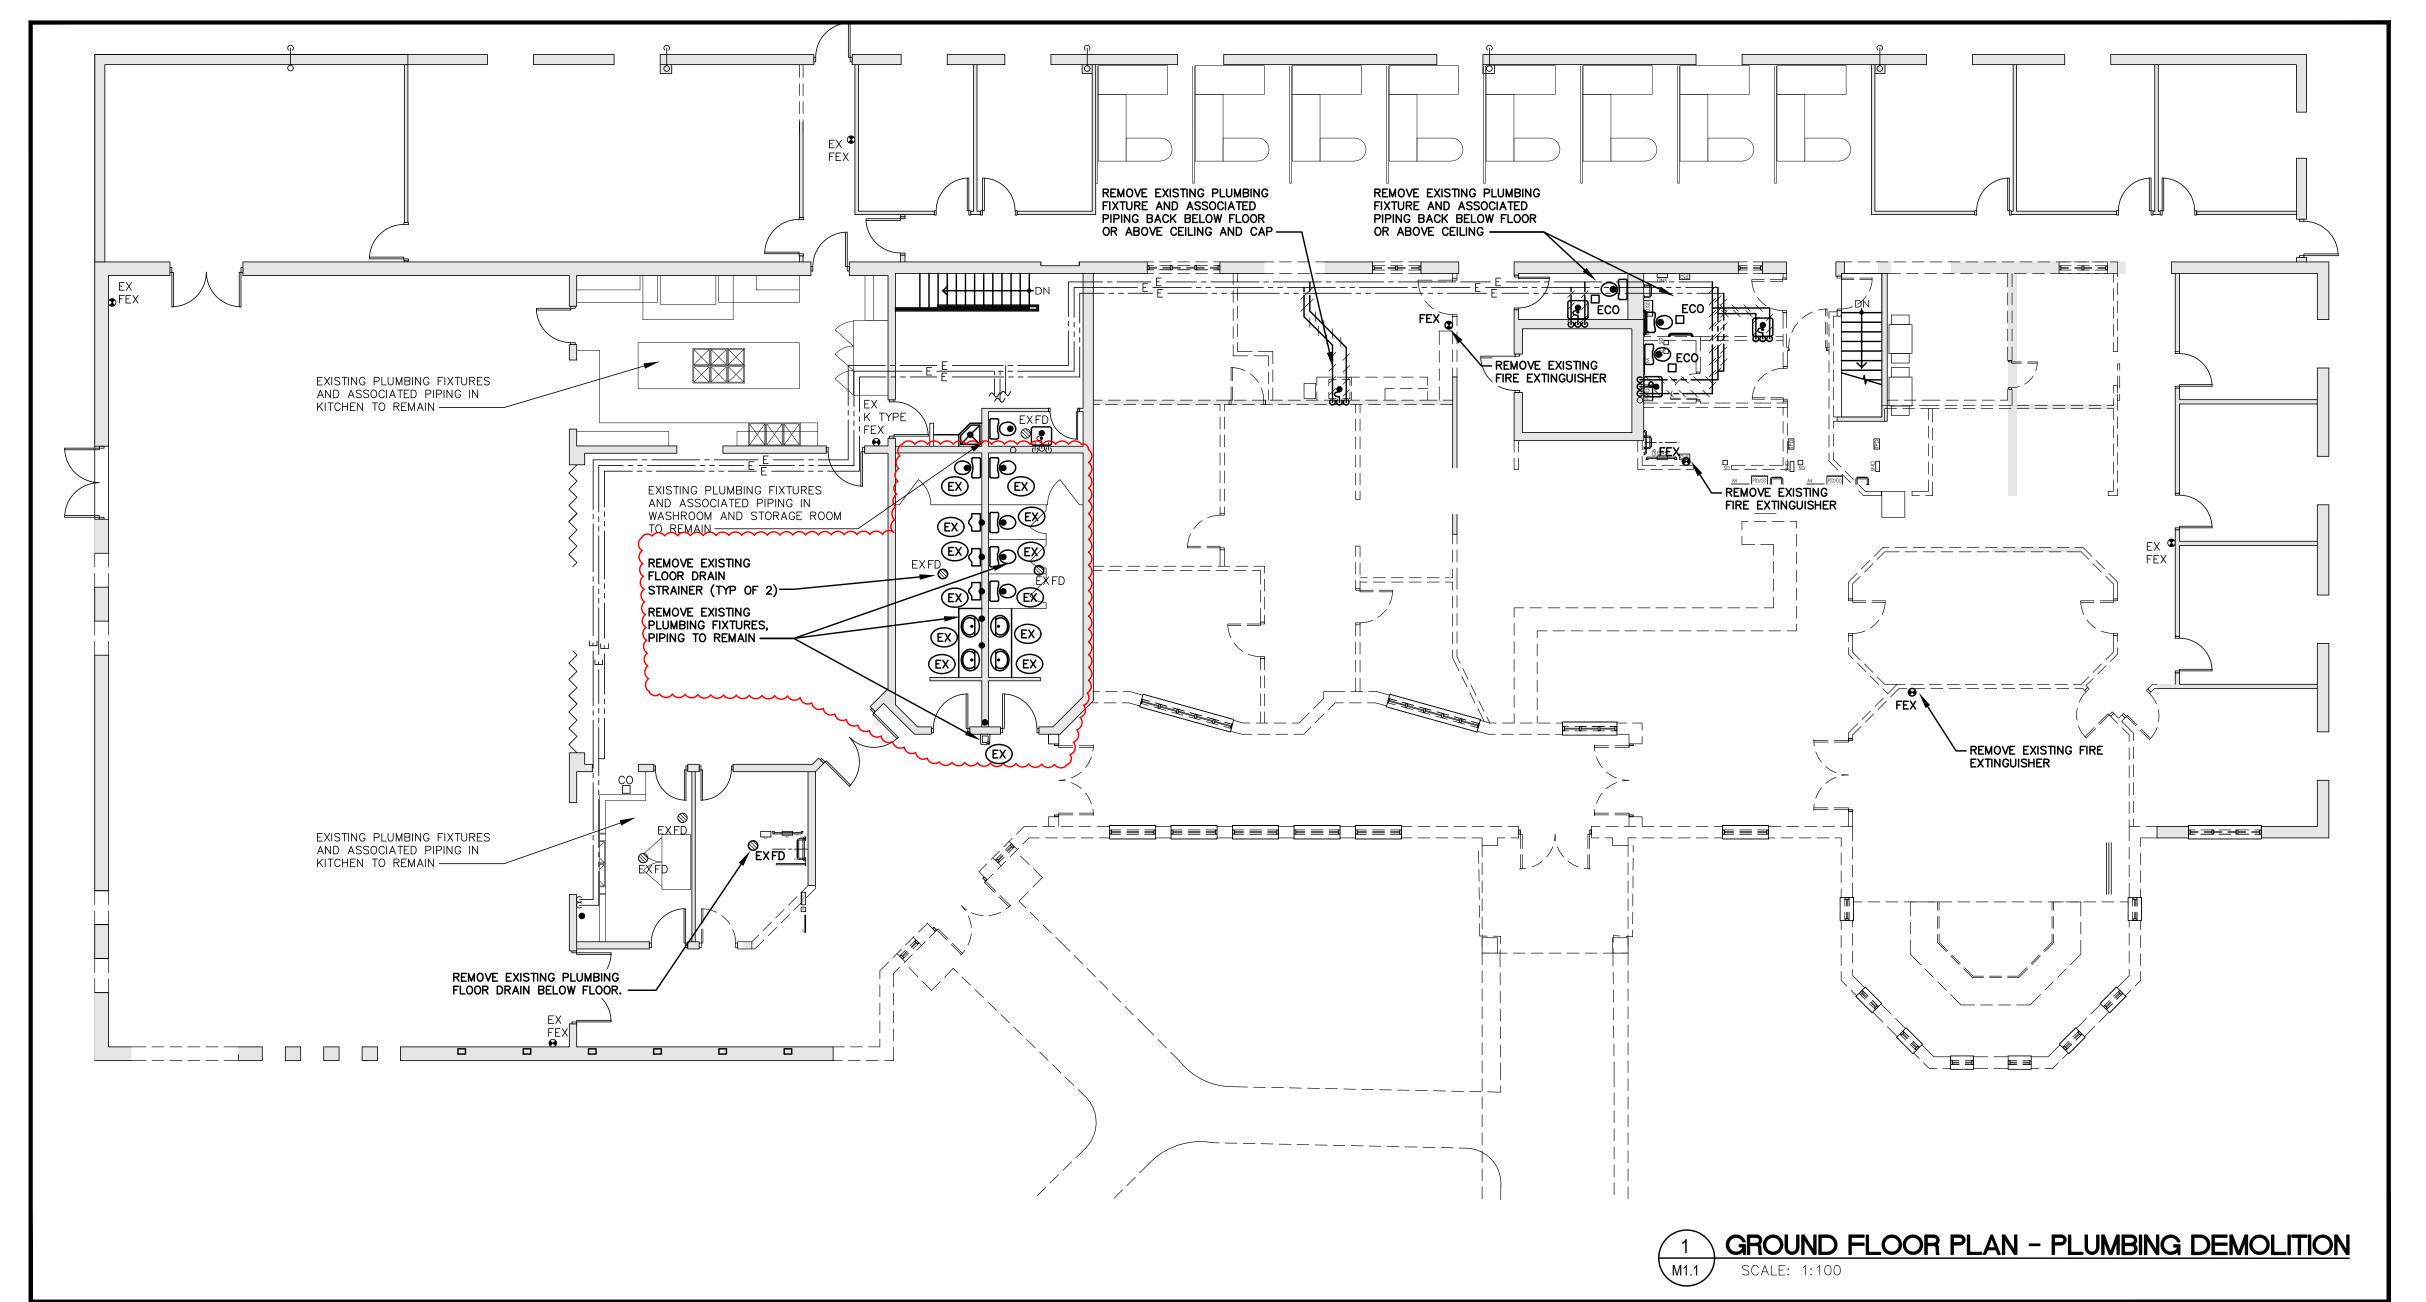

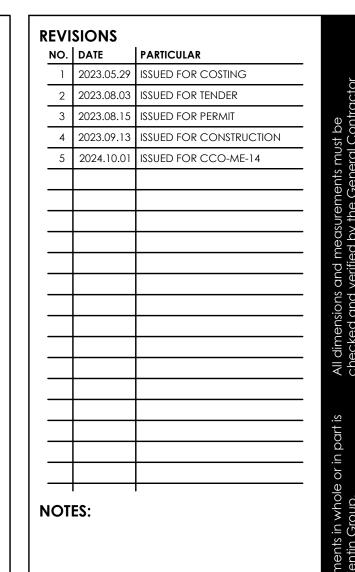

**KEY PLAN:** 

CLIENT:

COLDSTREAM MUNICIPAL OFFICE

PROJECT:


22281

COLDSTREAM MUNICIPAL OFFICE


10227 ILDERTON RD, ILDERTON, ON NOM 2A0

ORIGINAL PAGE SIZE ARCH D - 24" x 36" KEY TO DETAIL LOCATION: A - DETAIL NO. B - DETAIL NO. ORIGIN



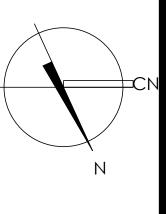

V&R# 23-006

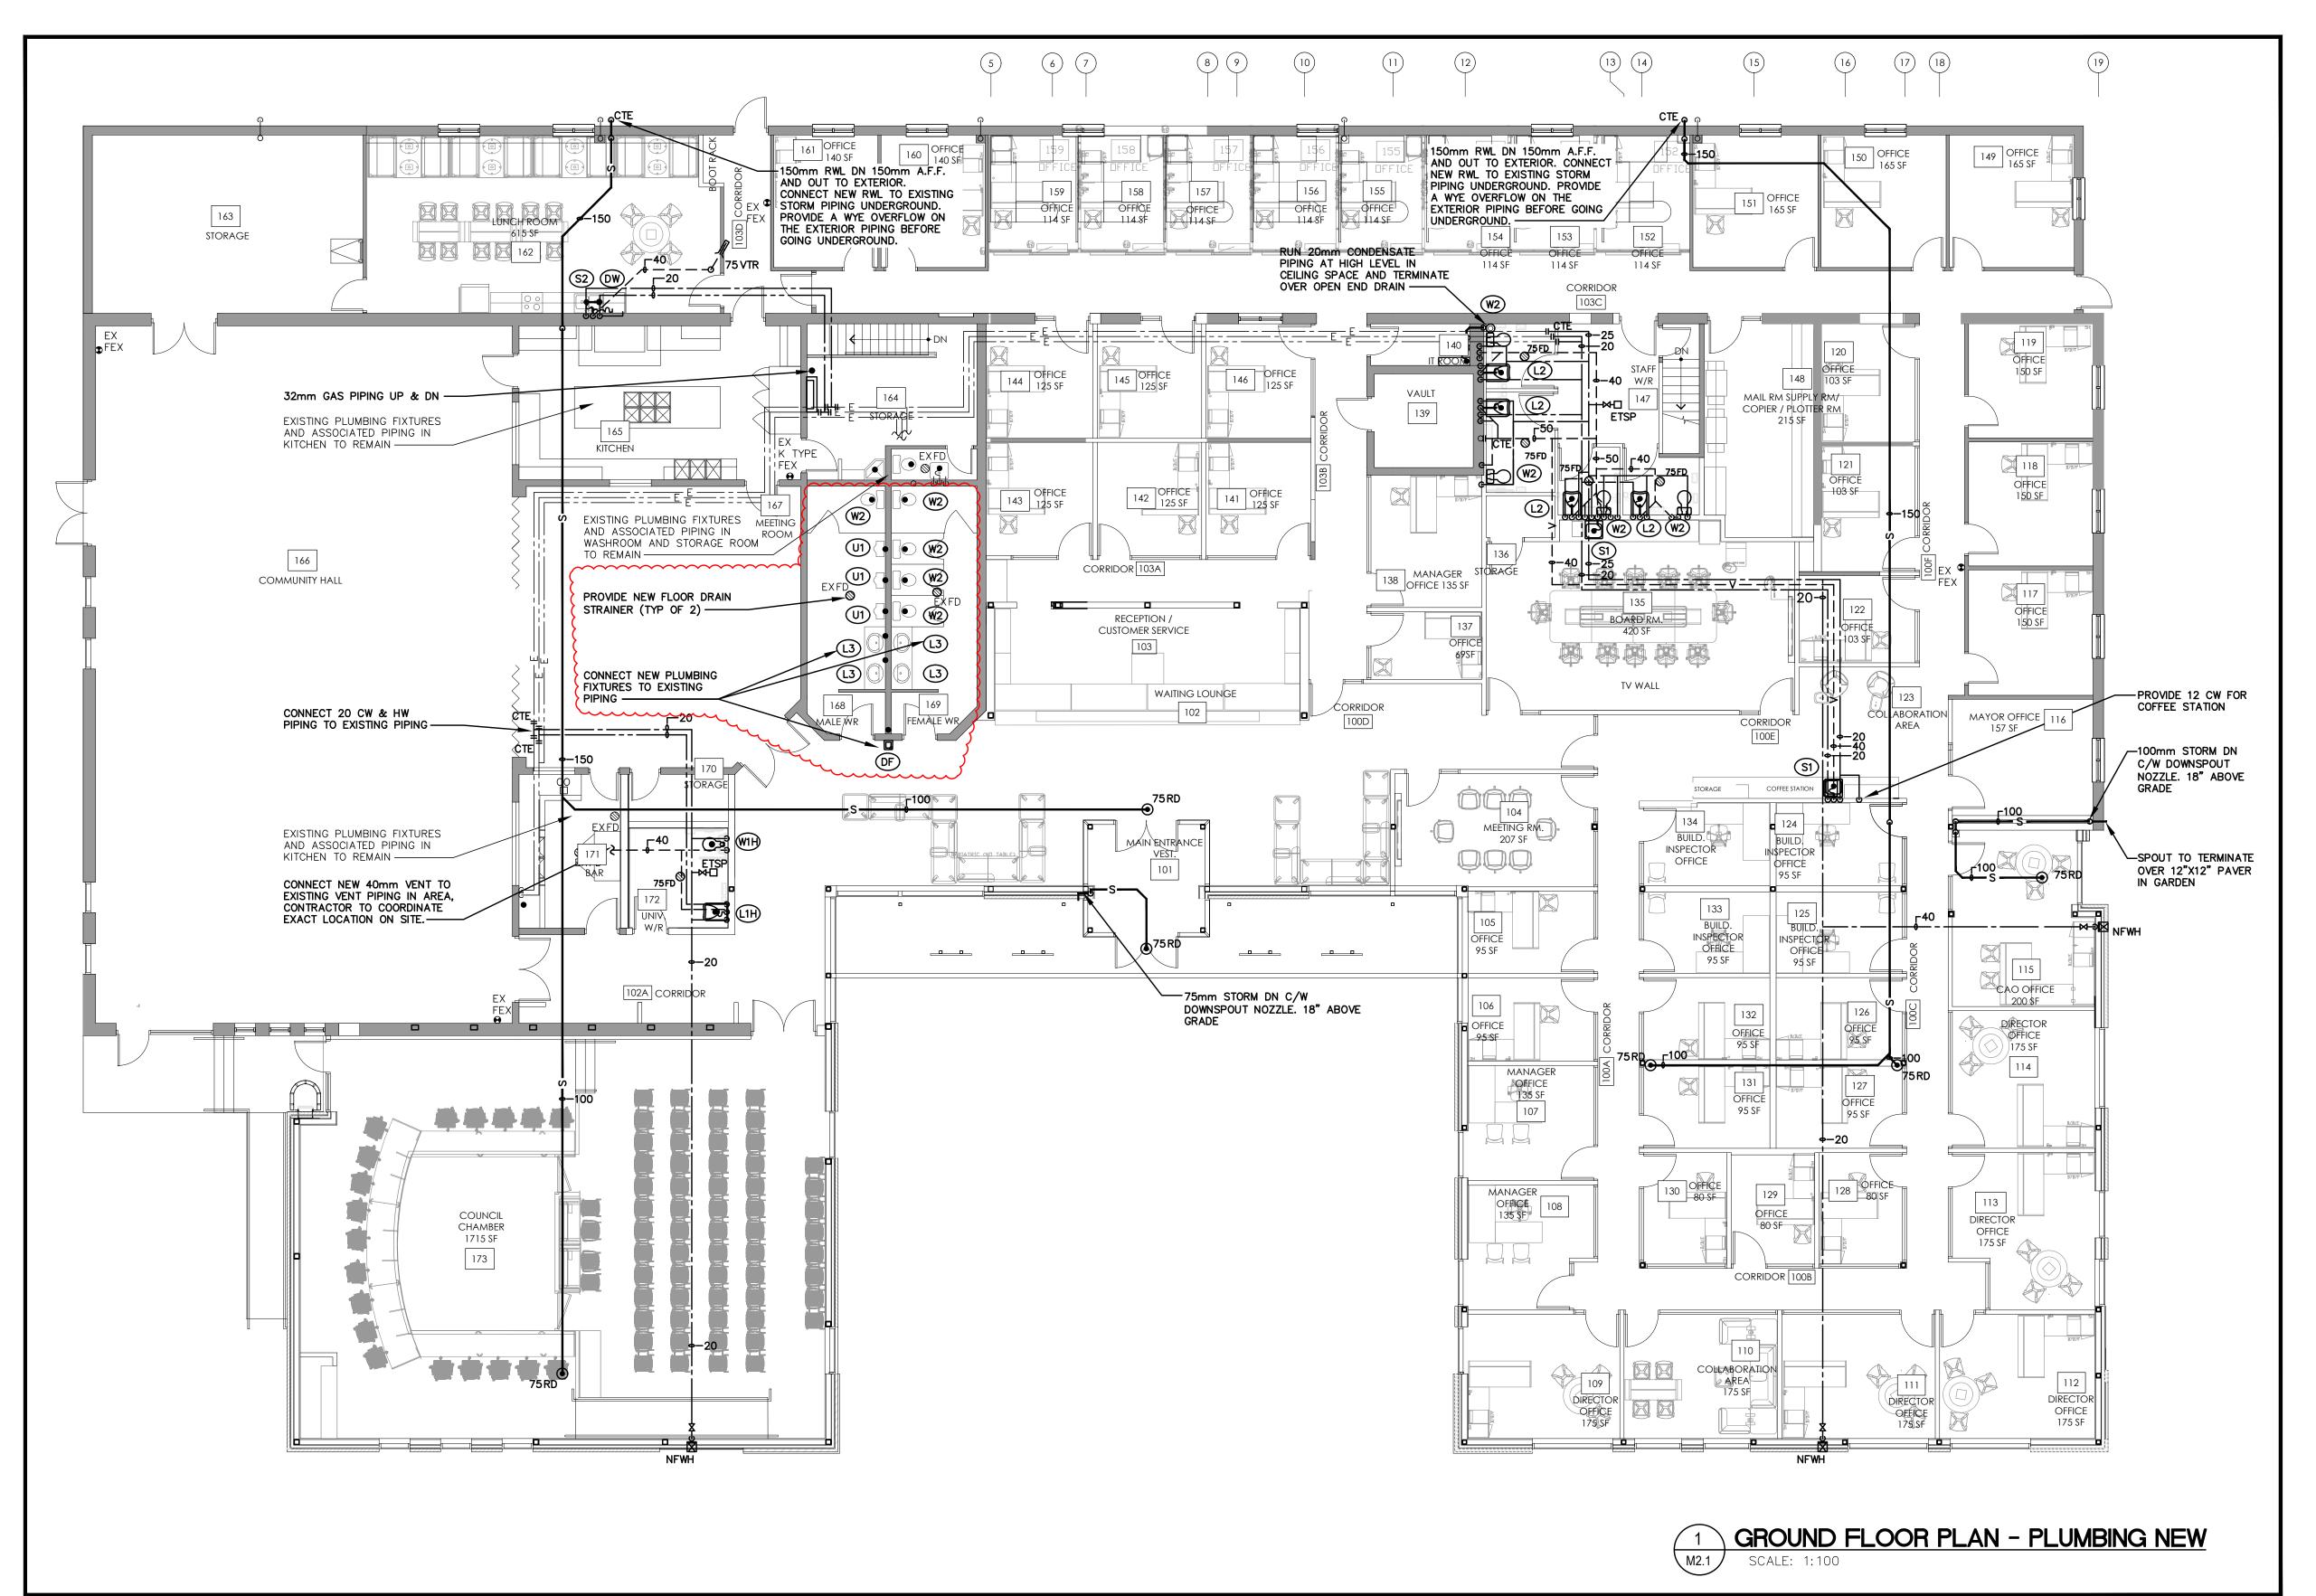

PLUMBING FIXTURE SCHEDULE						
REFER	DESCRIPTION	SAN	VENT	HOT	COLD	
U1	URINAL - W.H. F.V.	2"	1-1/2"		3/4"	
L3	LAVATORY - C.M.	1-1/2"	1-1/4"	1/2"	1/2"	
OF)	DRINKING FOUNTAIN	1-1/2"	1-1/4"		1/2"	

PL	JMBING FIXTURE SCH		JLE		
REFER	DESCRIPTION	SAN	VENT	НОТ	COLD
W1H)	WATER CLOSET - F.M. F.T. B.F.	3"	1-1/2"		3/4"
W2	WATER CLOSET - F.M. F.T.	3"	1-1/2"		3/4"
L1H)	LAVATORY - W.H. B.F.	1-1/2"	1-1/4"	1/2"	1/2"
L2	LAVATORY - W.H.	1-1/2"	1-1/4"	1/2"	1/2"
S1	S.S. SINK 1 COMP - C.M.	1-1/2"	1-1/2"	1/2"	1/2"
<u>S2</u>	S.S. SINK 2 COMP - C.M.	1-1/2"	1-1/2"	1/2"	1/2"
	WALL HUNG F.M. — FLOOR MOD BARRIE FREE F.T. — FLUSH TAN				

NO.	DATE	PARTICULAR
1	2023.05.29	ISSUED FOR COSTING
2	2023.08.03	ISSUED FOR TENDER
3	2023.08.15	ISSUED FOR PERMIT
4	2023.08.17	ISSUED FOR ADDENDUM ME 01
5	2023.08.25	ISSUED FOR ADDENDUM ME 02
6	2023.09.13	ISSUED FOR CONSTRUCTION
7	2023.11.09	ISSUED FOR CCO-ME-01
8	2024.07.31	ISSUED FOR CCO-ME-07
9	2024.08.28	ISSUED FOR CCO-ME-09
10	2024.09.26	ISSUED FOR CCO-ME-12
11	2024.10.01	ISSUED FOR CCO-ME-14
IOT	ES:	•

**KEY PLAN:** 


COLDSTREAM MUNICIPAL OFFICE


PROJECT: 22281

COLDSTREAM MUNICIPAL OFFICE

10227 ILDERTON RD, ILDERTON, ON NOM 2A0


ORIGINAL PAGE SIZE ARCH D - 24" x 36" KEY TO DETAIL LOCATION: A - DETAIL NO. B - DETAIL NO. ORIGIN

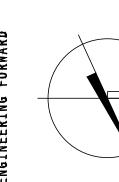

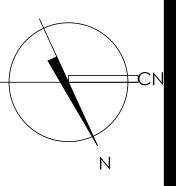

V&R# 23-006


M2.1.5

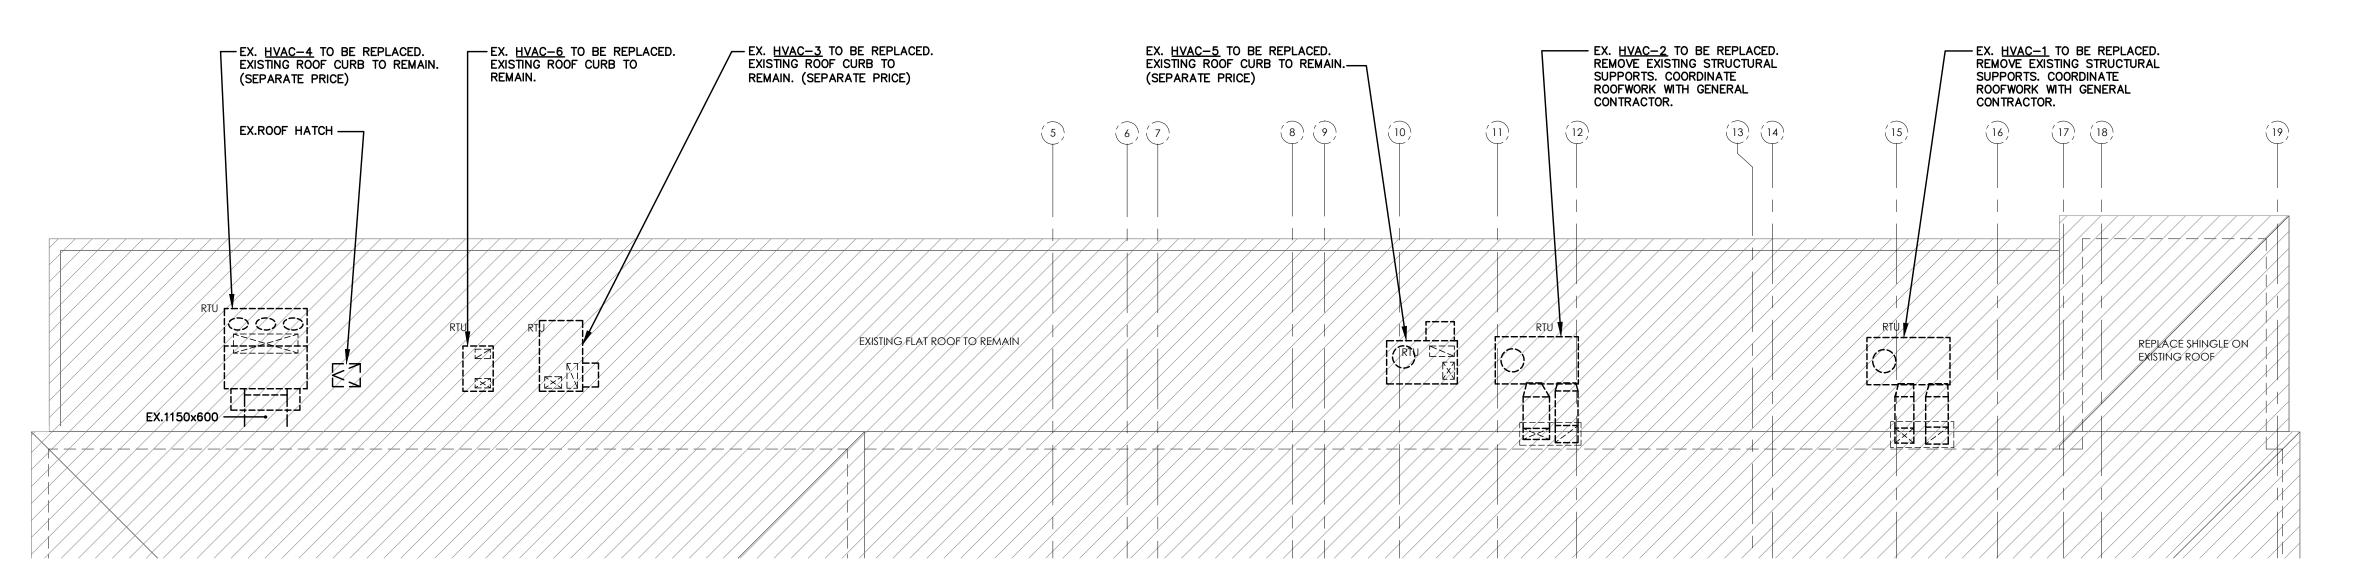

ROOF PLAN - DEMOLITION SCALE: 1:100

# **GENERAL NOTES:**

- 1. REFER TO DRAWING MOO1 FOR LEGEND OF SYMBOLS AND NOTES.
- 2. AIR OUTLETS (DIFFUSERS / GRILLES): TAG DESIGNATION
  AIRFLOW - L/S
- 3. REMOVE EXISTING EQUIPMENT DUCTWORK, AND PIPING AS INDICATED. CONTROLS CONTRACTOR SHALL DISCONNECT ALL ASSOCIATED CONTROLS EQUIPMENT PRIOR TO DEMOLITION OF MECHANICAL EQUIPMENT.
- 4. REPAIR OF WALLS, FLOORS AND ROOF SHALL BE BY THE GENERAL CONTRACTOR.
- 5. PROVIDE TEMPORARY FILTER MEDIA ON ALL AIR OPENING THAT MAY BE AFFECTED BY DUST OR DEBRIS FROM CONSTRUCTION WORK. FILTERS SHALL BE REPLACED WHEN NECESSARY AND WHEN CONSTRUCTION IS COMPLETE.
- 6. THE MECHANICAL CONTRACTOR SHOULD REMOVE THERMOSTATS OF EX. ROOFTOP UNITS AND REPLACE NEW THERMOSTATS FOR NEW ROOFTOP UNITS IN THE SAME

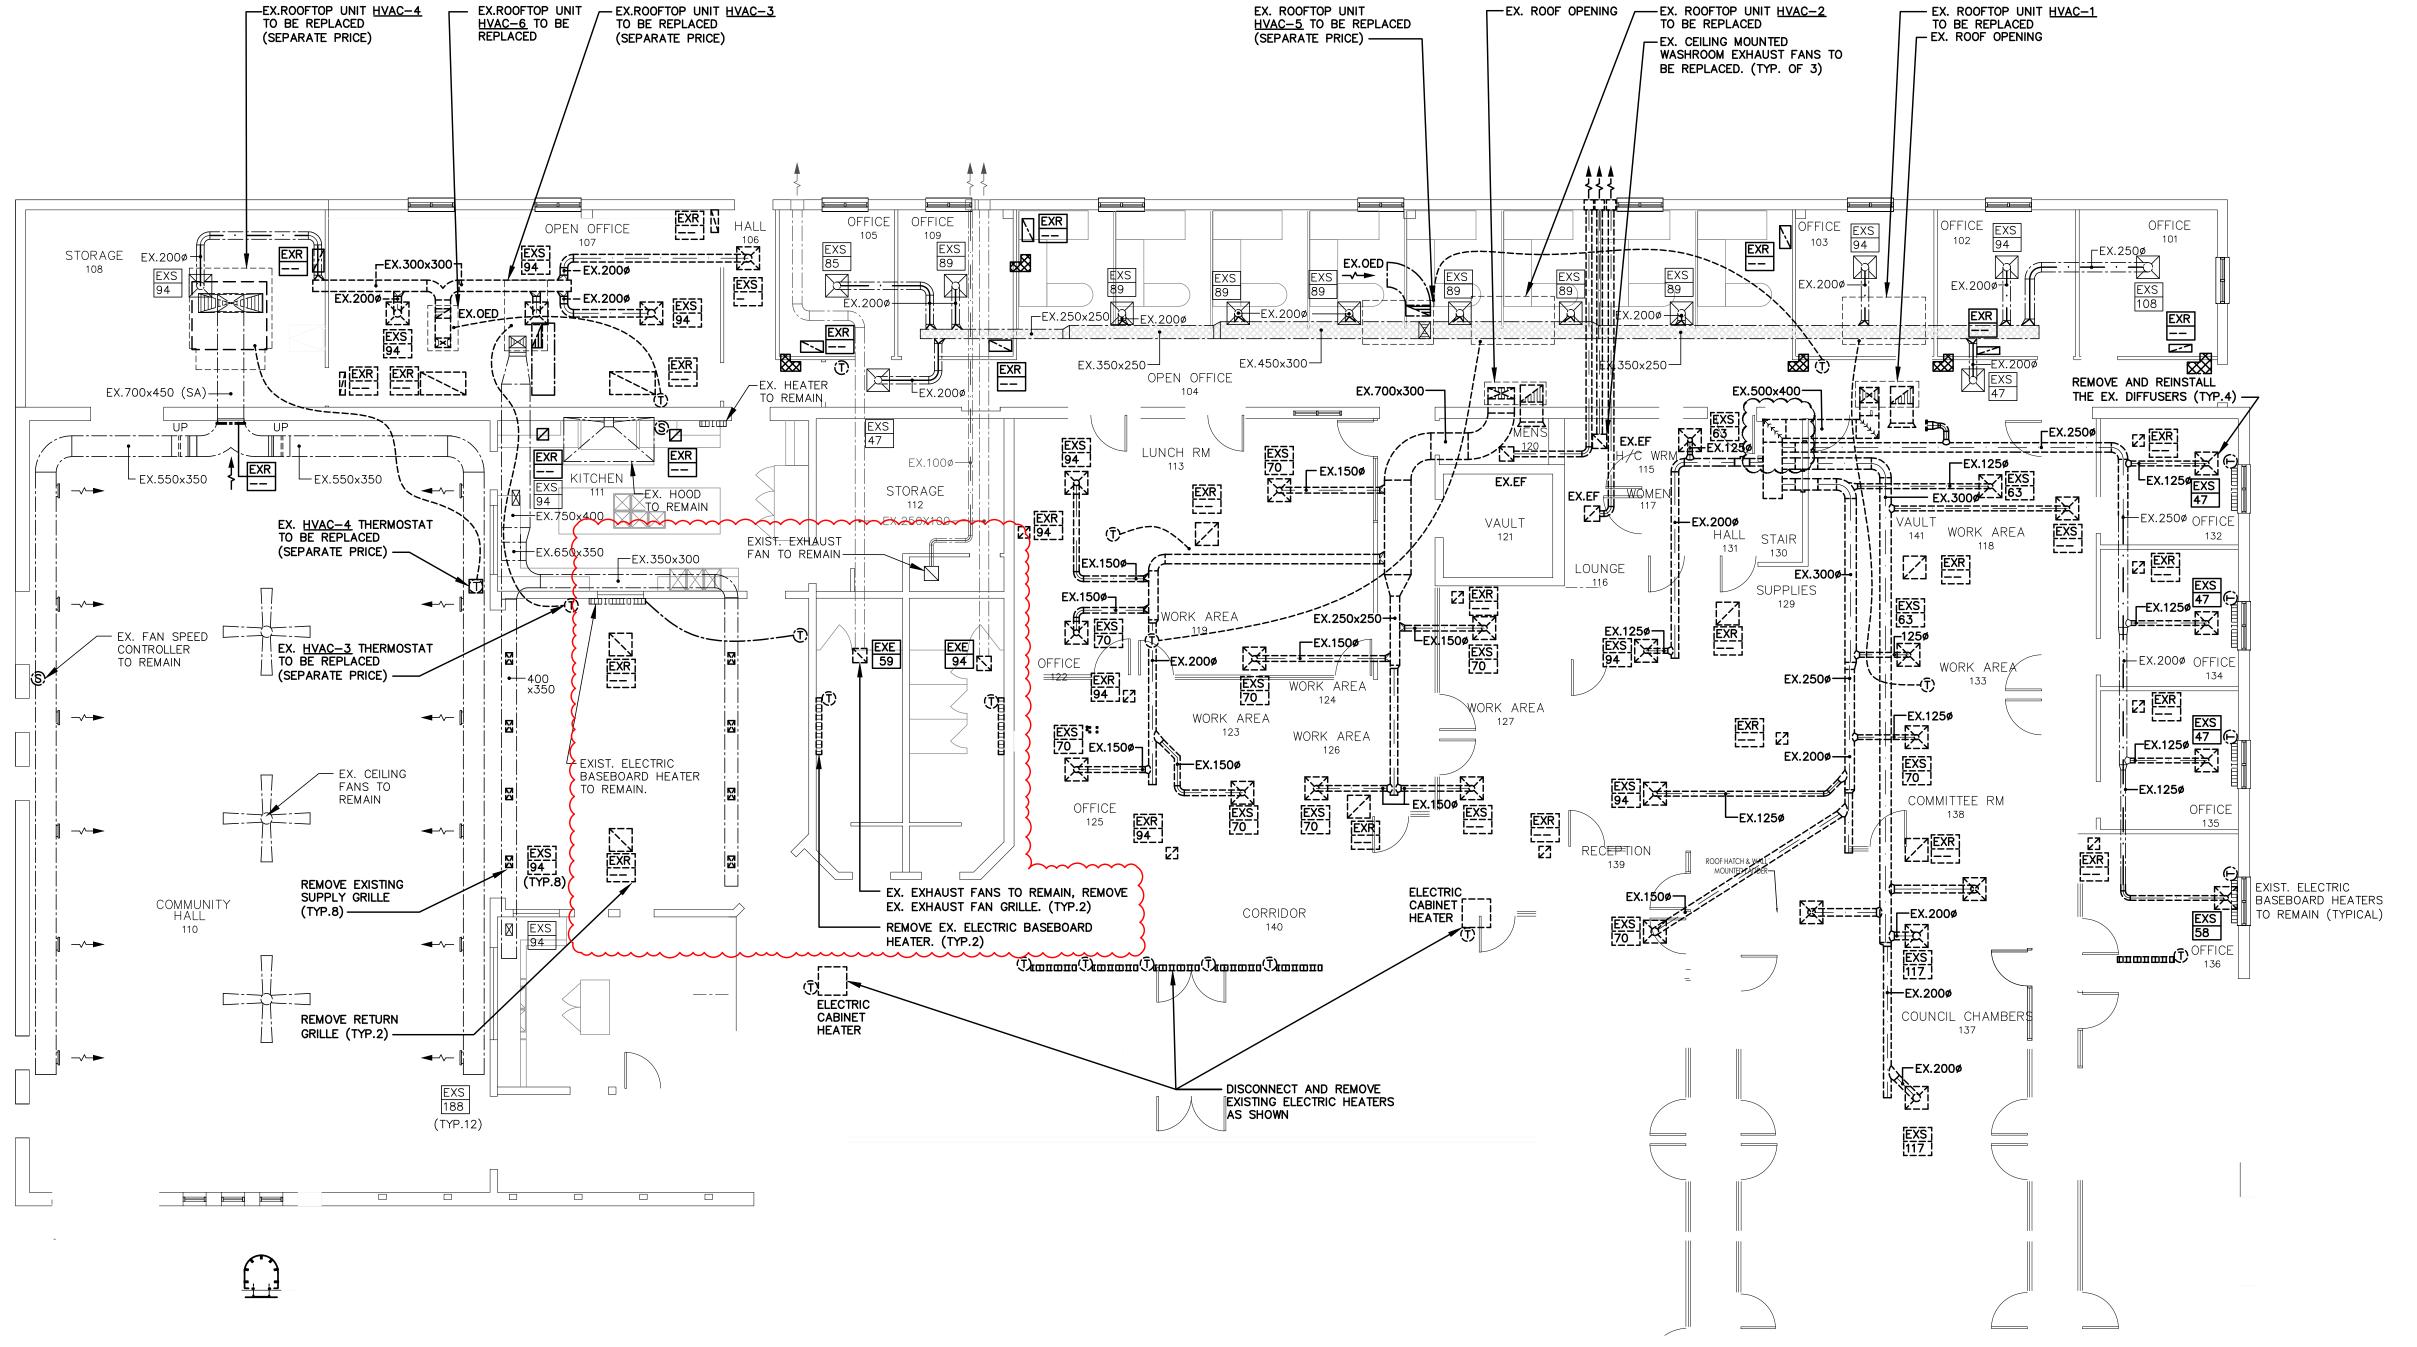


GROUND FLOOR PLAN - HVAC - DEMOLITION

M3.0 | SCALE: 1:100

**REVISIONS** NO. DATE PARTICULAR 1 2023.05.29 ISSUED FOR COSTING 2 2023.08.03 ISSUED FOR TENDER 3 | 2023.08.15 | ISSUED FOR PERMIT 4 2023.09.13 ISSUED FOR CONSTRUCTION 5 | 2024.04.30 | ISSUED FOR CCO-ME-03 6 2024.10.01 ISSUED FOR CCO-ME-14 **NOTES:** KEY PLAN: CLIENT: COLDSTREAM MUNICIPAL OFFICE PROJECT: 22281 COLDSTREAM MUNICIPAL OFFICE 10227 ILDERTON RD, ILDERTON, ON NOM 2A0 ORIGINAL PAGE SIZE ARCH D - 24" x 36"

KEY TO DETAIL LOCATION: A - DETAIL NO. B B - DETAIL NO. ORIGIN



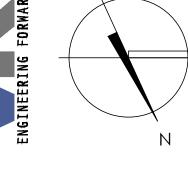

V&R# 23-006


## **GENERAL NOTES:**


- 1. THE UNIT OF DUCT DIMENSION IS MILLIMETER.
- 2. REFER TO DRAWING MO.1 FOR LEGEND OF SYMBOLS AND NOTES.
- 3. REFER TO MECHANICAL DETAILS AND MANUFACTURER MANUAL FOR MECHANICAL EQUIPMENT INSTALLATION REQUIREMENTS.
- 4. AIR OUTLET TAGS: S-1 TAG DESIGNATION L/S AIRFLOW - L/S
- 5. PROVIDE ACCESS DOOR'S WHERE REQUIRED TO ENSURE ACCESS TO ALL EQUIPMENT, DAMPERS, VALVES ETC. COORDINATE WITH CEILING PLAN AND ALL SUBTRADES FOR LOCATION.
- PROVIDE PROTECTION AND REPLACE FILTERS ON AIR INTAKE THAT MAY BECOME CONTAMINATED DUE TO DUST AND DEBRIS GENERATED DURING CONSTRUCTION
- 7. MECHANICAL CONTRACTOR SHALL ALLOW FOR OFFSETS IN DUCTWORK TO AVOID STRUCTURE.
- 8. REFER TO ARCHITECTURAL DRAWINGS, DETAILS, AND SPECIFICATIONS FOR ROOF AND WALL PENETRATIONS AND ROOFTOP EQUIPMENT SUPPORTS.
- 9. ALL DUCTS PENETRATING THE ATTIC SHALL BE INSTALLED COMPLETE WITH A FIRE DAMPER TO MAINTAIN FIRE SEPARATION. REFER TO ARCHITECTURAL DRAWINGS FOR FIRE SEPARATION RATINGS.
- 10. PROVIDE ACOUSTICAL LINING FOR ALL DUCTWORK WITHIN 10 FEET OF THE MECHANICAL UNITS.

## DRAWING NOTES :

- 12"X12" VAV BYPASS DUCT C/W
  MOTORIZED DAMPER WIRED TO THE CONTROLLER OF ITS ROOFTOP UNIT
- FIRE DAMPERS TO BE INSTALLED ON SUPPLY AND RETURN DUCTS PENETRATING THE ROOF.
- 3 100MM BOILER VENT AND 100MM AIR INTAKE VENT UP THROUGH RATED ENCLOSURE FROM BASEMENT UP THROUGH ROOF. INSTALLED MATERIALS AND TERMINATIONS AS PER MANUFACTURER AND CSA B149.1 REQUIREMENTS. PROVIDE CONTINUOUS 1 HOUR FRR SHAFTWALL FROM GROUND FLOOR TO UNDERSIDE OF
- EXISTING ROOF. WIRE CONTROL OF ELECTRIC BASEBOARD HEATER TO ZONE VAV

THERMOSTAT.

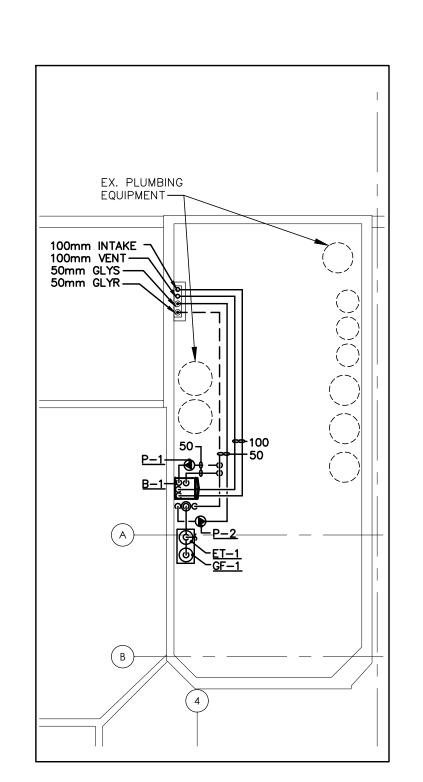

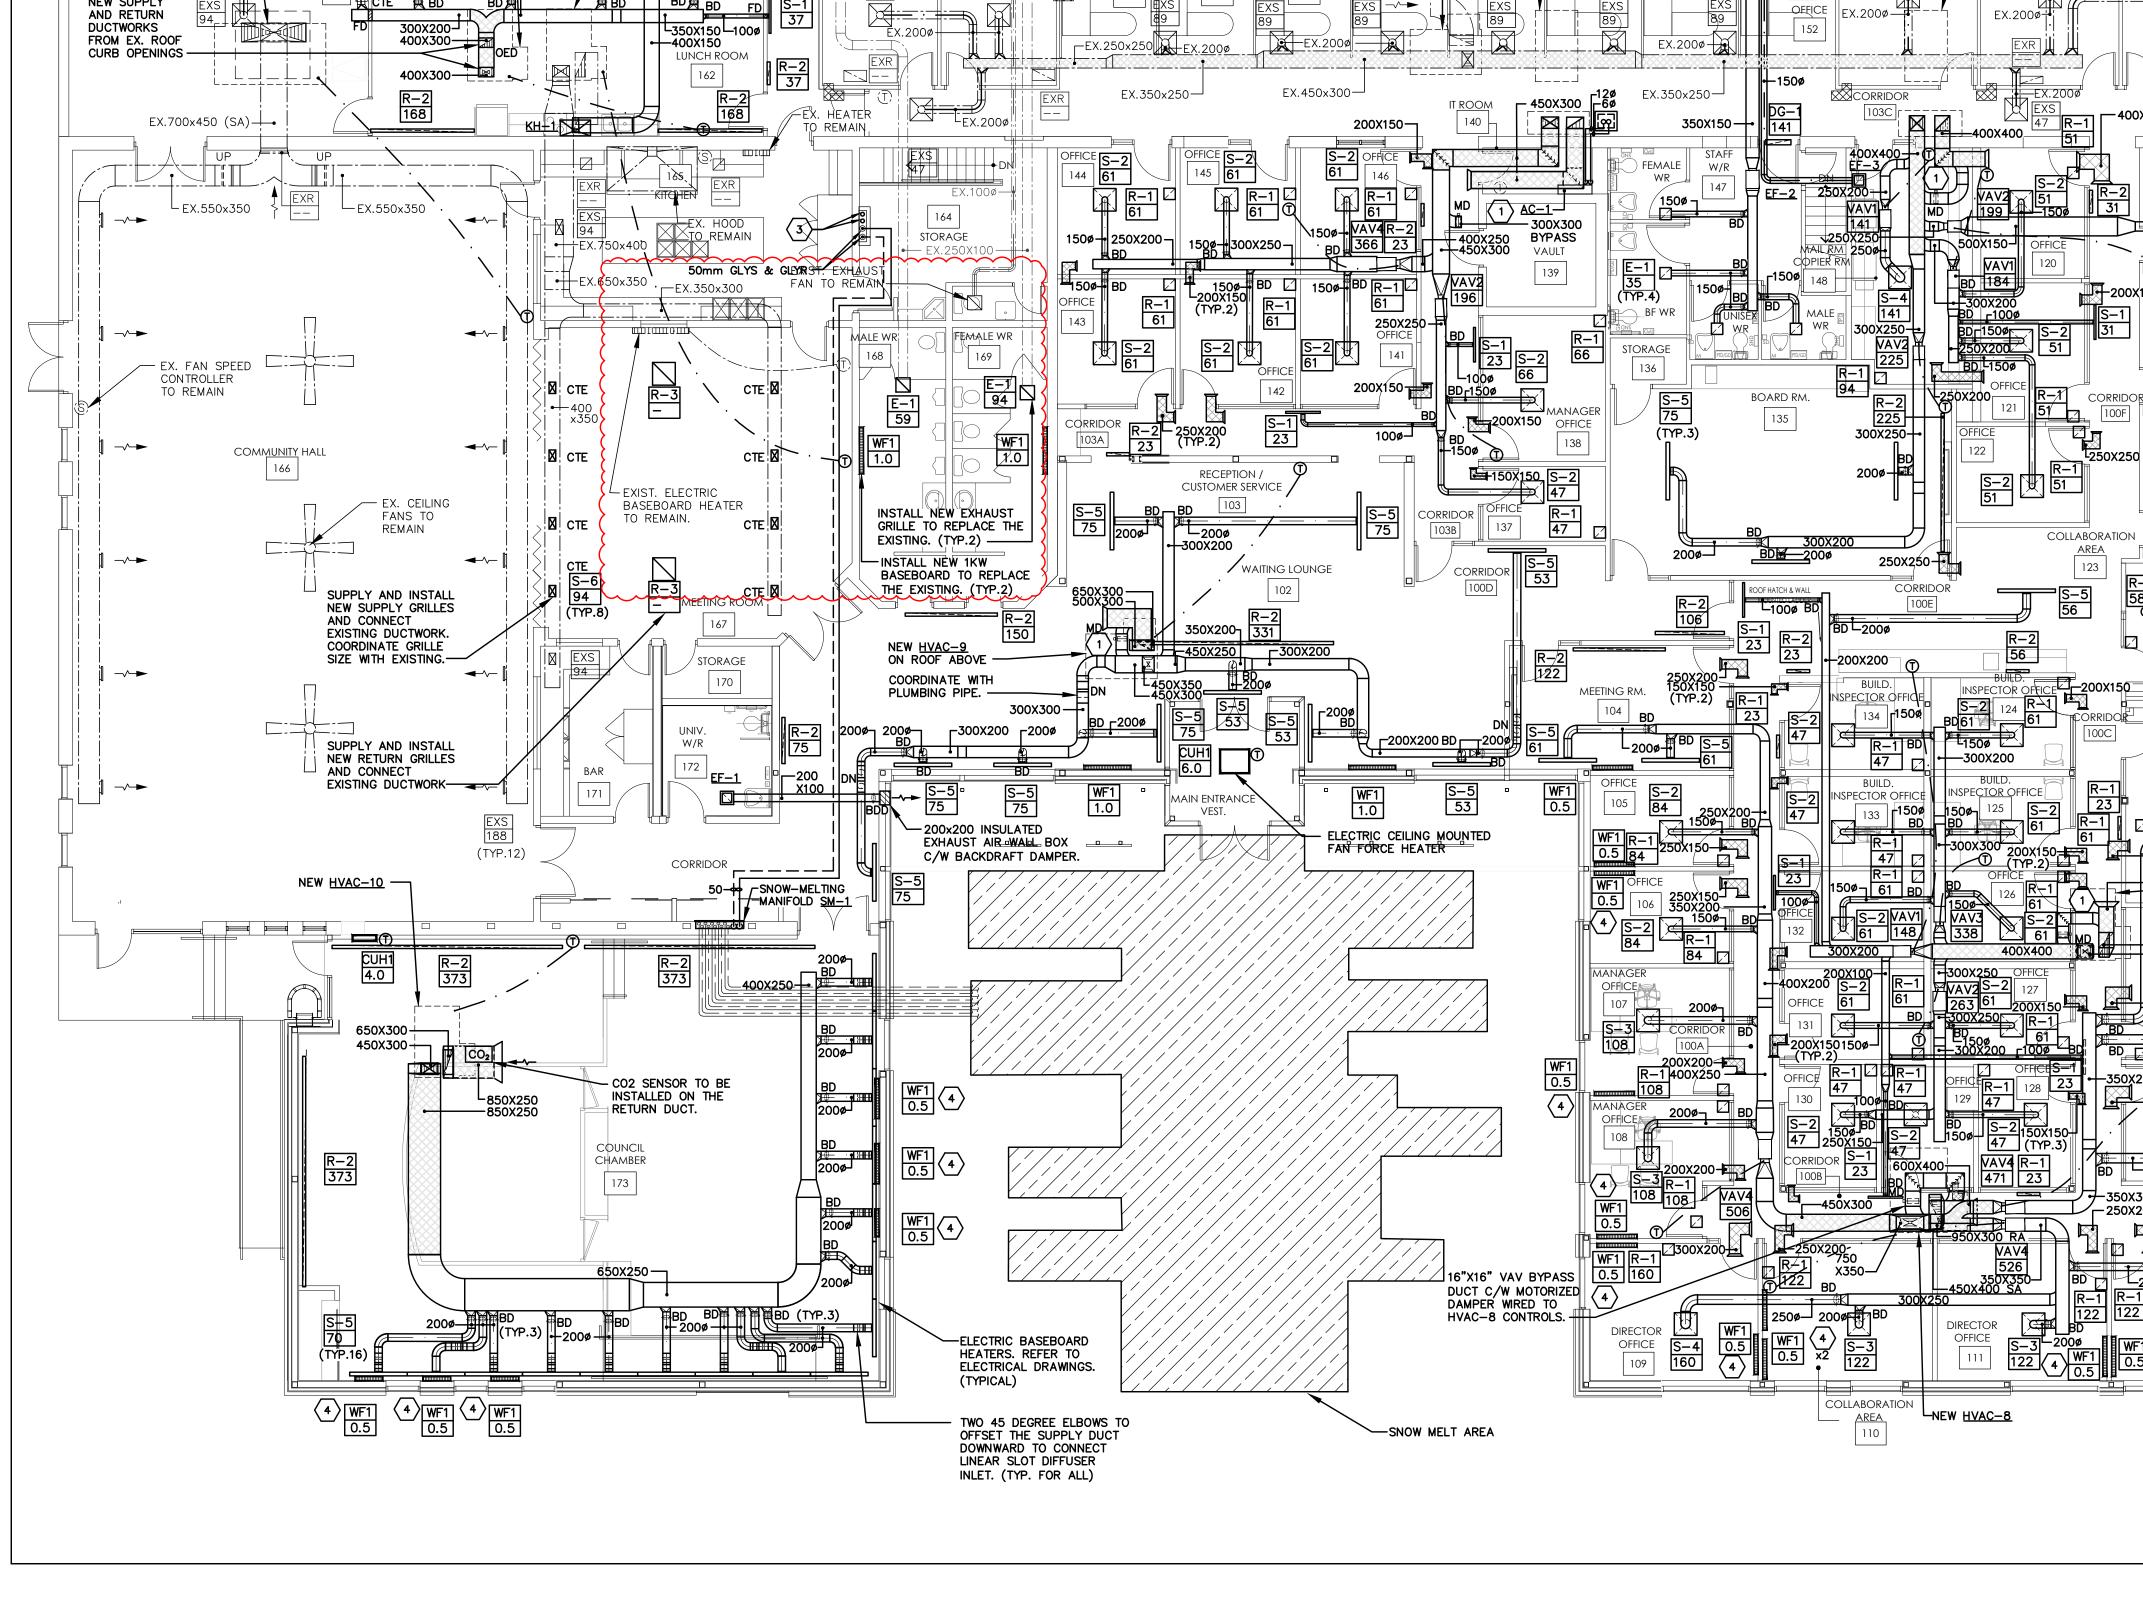

NEW HVAC-6

—— NEW <u>HVAC-3</u> (SEPARATE PRICE)

OFFICE OFFICE

600x300 INSULATED

EXHAUST AIR LOUVRE

NEW <u>HVAC-4</u> (SEPARATE PRICE)

163


STORAGE

**NEW SUPPLY** 

AND RETURN

DUCTWORKS

EX.200ø-

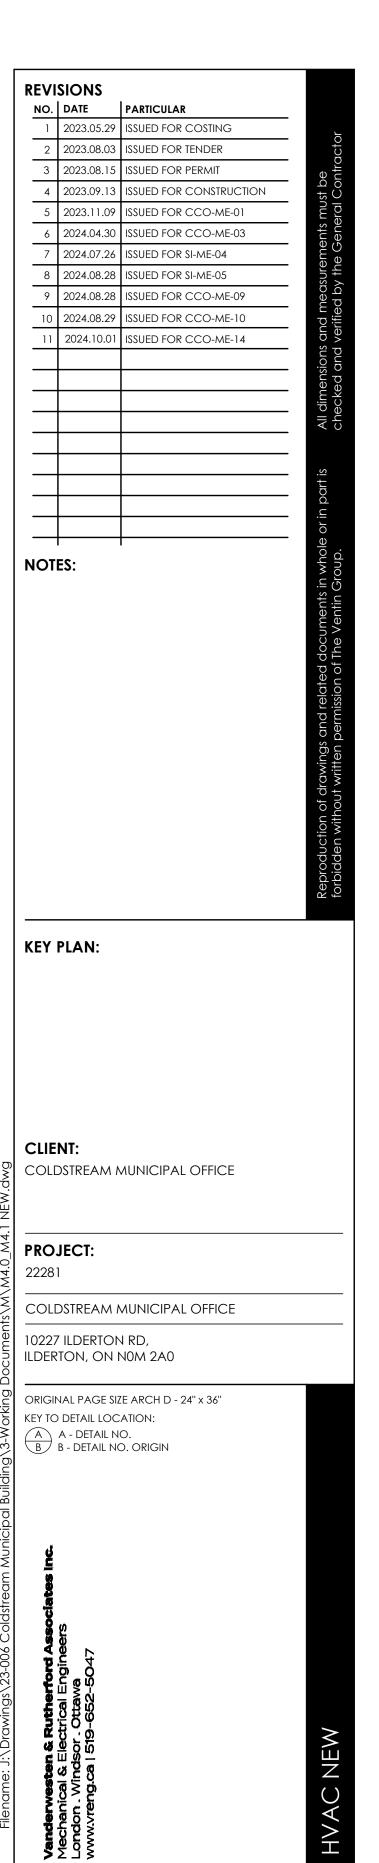



← 600×450 INSULATED

EXHAUST AIR LOUVRE

OFFICE ||EX.2000

MEW HVAC-1

EX.200ø∓

123

300X200

BDL<sub>125ø</sub>

MAYOR OFFICE

-REINSTALL EX.

(TYP.4)

SUPPLY DIFFUSERS.

-CONNECT THE NEW

DUCT FROM EX. DUCT

BRANCH SUPPLY

TAKE-OFF.

(TYP.3)

EXIST. ELECTRIC

₩ NEW <u>HVAC-7</u>

BASEBOARD HEATERS

TO REMAIN (TYPICAL)

REINSTALL EXISTING ELECTRIC BASEBOARD HEATER

- ELECTRIC BASEBOARD

HEATERS (TYPICAL)

---ELECTRIC BASEBOARD HEATERS. REFER TO ELECTRICAL DRAWINGS.

(TYPICAL)


- REMOVE AND

— NEW <u>HVAC-2</u>

NEW <u>HVAC-5</u> (SEPARATE PRICE) ——

M4.0.7

V&R# 23-006

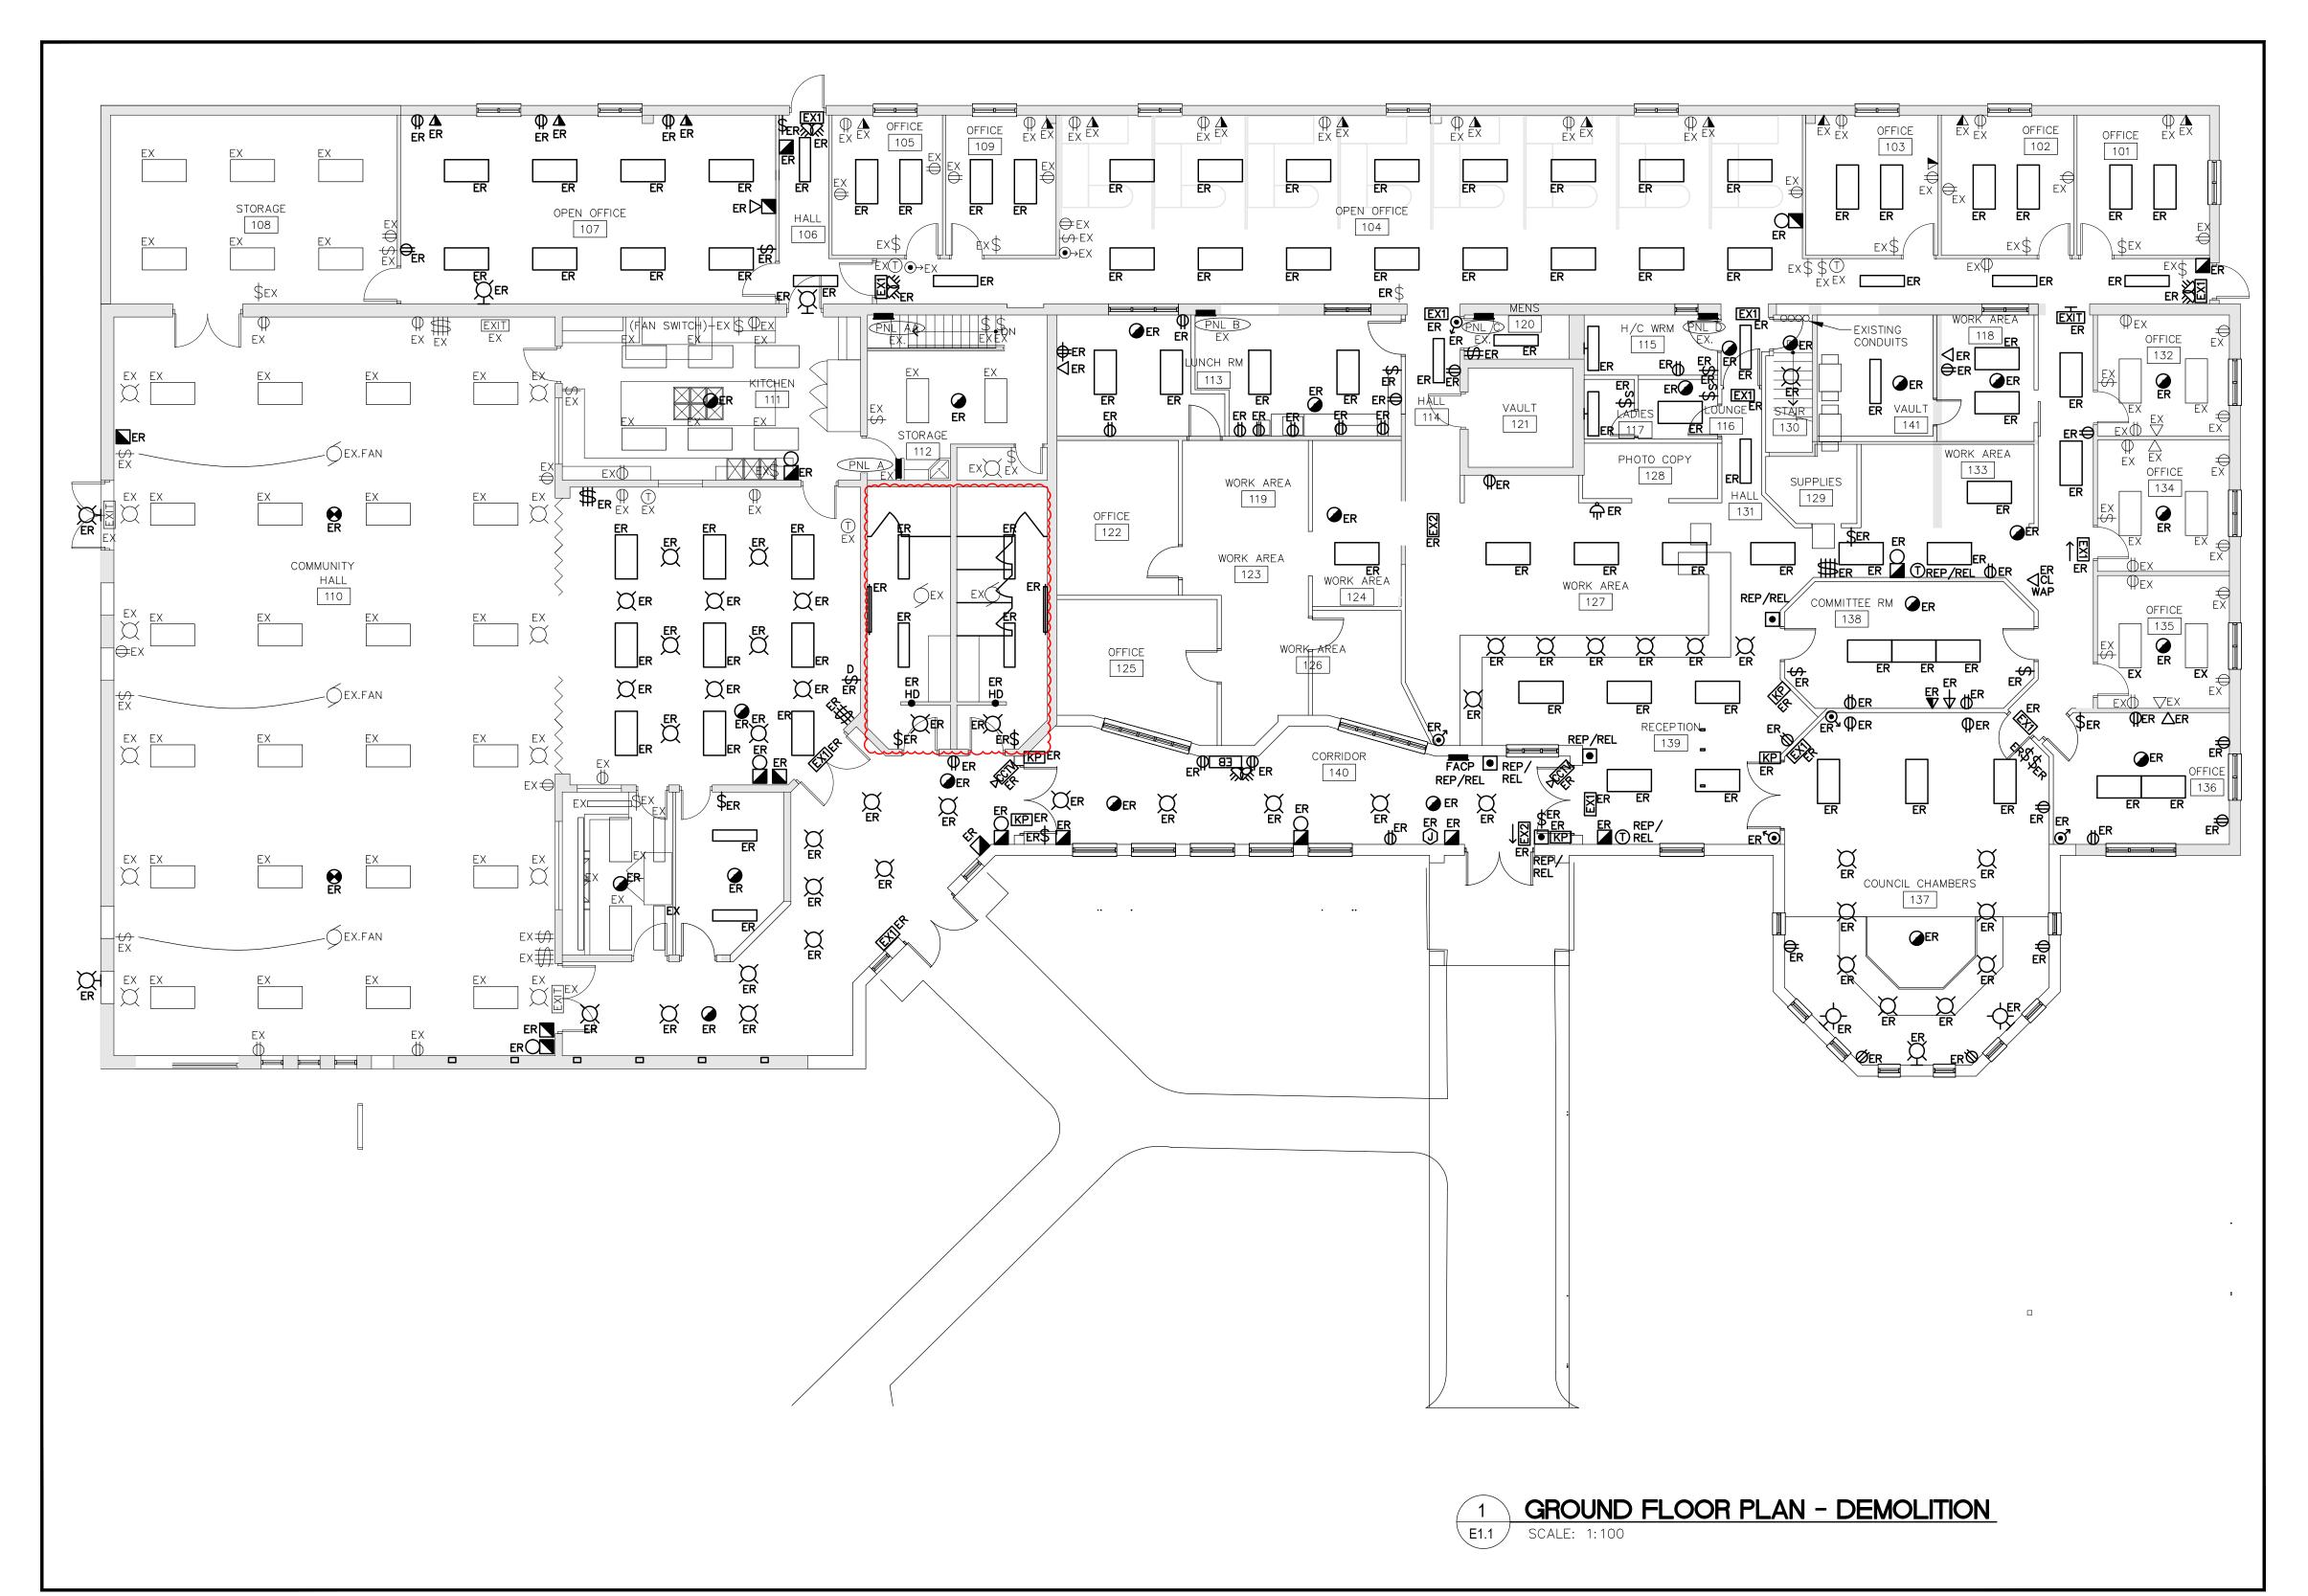


## DEMOLITION GENERAL NOTES


RECORD DRAWINGS.


- VISIT SITE PRIOR TO BID AND VERIFY EXTENT OF REMOVAL AND REARRANGEMENT WORK.
- 2. ELECTRICAL SYSTEMS SHOWN ON DEMOLITION PLANS ARE BASED ON INFORMATION OBTAINED FROM ORIGINAL CONSTRUCTION CONTRACT / TENDER DOCUMENTS. THESE DRAWINGS ARE NOT BASED ON "AS-BUILT RECORDS" OR ON EXHAUSTIVE FIELD MEASUREMENT AND ARE PROVIDED TO ASSIST THE CONTRACTOR IN DETERMINING THE EXTENT OF REQUIRED WORK. CONTRACTOR SHALL MAKE ALLOWANCE IN THEIR TENDER PRICE FOR THE REMOVAL OF ADDITIONAL ABANDONED SERVICES AND THE PROTECTION OF EXISTING SERVICES THAT REMAIN. RECORD THE LOCATION OF ALL EXISTING SERVICES THAT REMAIN ON AS-BUILT
- EXISTING DEVICES/EQUIPMENT/LUMINAIRES IN LIGHT LINES TAGGED WITH 'EX' ARE EXISTING TO REMAIN.
- 4. EXISTING DEVICES/EQUIPMENT/LUMINAIRES IN HEAVY LINES TAGGED WITH 'REL' ARE TO BE DISCONNECTED, RELOCATED TO NEW LOCATION, AND RECONNECTED. FOR EACH DEVICE/ EQUIPMENT, MODIFY AND EXTEND EXISTING CONDUIT AND WRING TO NEW LOCATION AS REQUIRED, UNLESS NOTED OTHERWISE.
- 5. EXISTING DEVICES/EQUIPMENT/LUMINAIRES IN HEAVY LINES TAGGED WITH 'REP' ARE TO BE DISCONNECTED, REMOVED, AND REPLACED WITH NEW. FOR EACH DEVICE/EQUIPMENT/LUMINAIRE, REMOVE ITS ASSOCIATED WIRING BACK TO SOURCE. PROVIDE NEW REPLACEMENT DEVICE/EQUIPMENT/LUMINAIRE AND RECONNECT WITH NEW WIRING IN CONDUIT. EXISTING CONDUIT MAY BE REUSED TO THE GREATEST EXTENT POSSIBLE.
- EXISTING DEVICES/EQUIPMENT/LUMINAIRES IN HEAVY LINES TAGGED WITH 'REP/REL' ARE EXISTING TO BE DISCONNECTED, REMOVED, AND REPLACED WITH NEW AT A NEW LOCATION. REMOVE ITS ASSOCIATED WIRING BACK TO SOURCE. PROVIDE REPLACEMENT DEVICE/EQUIPMENT/LUMINAIRE AND CONNECT WITH NEW WIRING IN CONDUIT. MODIFY AND EXTEND EXISTING CONDUIT TO NEW LOCATION AS REQUIRED.
- 7. EXISTING DEVICES/EQUIPMENT/LUMINAIRES IN HEAVY LINES THAT ARE TAGGED WITH 'ER' ARE TO BE DISCONNECTED AND REMOVED IN THEIR ENTIRETY.
- 8. ELECTRICAL EQUIPMENT BEING REMOVED AND NOT BEING REUSED SHALL BE STORED ON SITE AND REMAIN THE PROPERTY OF THE OWNER. ANY SUCH EQUIPMENT THE OWNER DOES NOT WISH TO RETAIN SHALL BE REMOVED FROM SITE AND DISPOSED OF BY THIS TRADE.
- LEAVE SITE IN CLEAN AND TIDY MANNER WITH ALL REMAINING CONDUIT AND WIRING TERMINATED IN A PROFESSIONAL AND SAFE OPERATING MANNER.


	SIONS	la camani ca	
NO.	<b>DATE</b> 2023.05.29	ISSUED FOR COSTING	
2	2023.08.03	ISSUED FOR TENDER	
3	2023.08.15	ISSUED FOR PERMIT	oe Oe
4	2023.09.13	ISSUED FOR IFC	ust k
<u>5</u> 6	2024.04.30 2024.08.13	ISSUED CCO-ME-03 ISSUED CCO-ME-06R1	nts m
7	2024.09.16		emer
8	2024.10.01	ISSUED CCO-ME-14	All dimensions and measurements must be
			d me
			s and
			nsion
			dime
			All o
			art is
			in po
			ole or
NOT	ES:	•	whole
			ed documents in whole or in part
			men
			docu
			ed d
			Reproduction of drawings and relations
			o sôu
			Tawir
			of d
			tion
			Reproduction of drawings and relat
			Repr
CLIE		MUNICIPAL OFFICE	
COL		MUNICIPAL OFFICE	
COL	JECT:	MUNICIPAL OFFICE	
PRO: 2228	JECT:	MUNICIPAL OFFICE	
PRO. 2228 COLL 10227	JECT: I DSTREAM I	MUNICIPAL OFFICE N RD,	
PRO. 2228 COLL 10227	JECT:  I  DSTREAM I	MUNICIPAL OFFICE N RD,	
PRO. 2228 COLL 10227 ILDER	JECT:  DSTREAM I  ILDERTON TON, ON I	MUNICIPAL OFFICE  N RD, NOM 2A0  ZE ARCH D - 24" x 36"	
PRO 2228 COLE 10227 ILDER ORIGIN	JECT:  DSTREAM I  ILDERTON TON, ON I  NAL PAGE SI  DETAIL LOC A - DETAIL N	MUNICIPAL OFFICE  N RD, NOM 2A0  ZE ARCH D - 24" x 36" CATION: O.	
PRO 2228 COLL 10227 ILDER ORIGIN KEY TO	JECT:  DSTREAM /  ILDERTON TON, ON I	MUNICIPAL OFFICE  N RD, NOM 2A0  ZE ARCH D - 24" x 36" CATION: O.	
PRO 2228 COLE 10227 ILDER ORIGIN	JECT:  DSTREAM I  ILDERTON TON, ON I  NAL PAGE SI  DETAIL LOC A - DETAIL N	MUNICIPAL OFFICE  N RD, NOM 2A0  ZE ARCH D - 24" x 36" CATION: O.	
PRO 2228 COLE 10227 ILDER ORIGIN	JECT:  DSTREAM I  ILDERTON TON, ON I  NAL PAGE SI  DETAIL LOC A - DETAIL N	MUNICIPAL OFFICE  N RD, NOM 2A0  ZE ARCH D - 24" x 36" CATION: O.	
PRO. 2228 COLL COLL COLL COLL COLL COLL COLL COL	JECT:  DSTREAM I  ILDERTON TON, ON I  NAL PAGE SI  DETAIL LOC A - DETAIL N	MUNICIPAL OFFICE  N RD, NOM 2A0  ZE ARCH D - 24" x 36" CATION: O.	
PRO. 2228 COLL COLL COLL COLL COLL COLL COLL COL	JECT:  I  DSTREAM I  ILDERTON TON, ON I  NAL PAGE SI  DETAIL LOC A - DETAIL NO B - DETAIL NO	MUNICIPAL OFFICE  N RD, NOM 2A0  ZE ARCH D - 24" x 36" CATION: O.	
PRO. 2228 COLL COLL COLL COLL COLL COLL COLL COL	JECT:  I  DSTREAM I  ILDERTON TON, ON I  NAL PAGE SI  DETAIL LOC A - DETAIL NO B - DETAIL NO	MUNICIPAL OFFICE  N RD, NOM 2A0  ZE ARCH D - 24" x 36" CATION: O.	
PRO 2228 COLL TO THE PRO COLL TO THE PROTOCOLUTION TO THE P	JECT:  DSTREAM I  ILDERTON TON, ON I  NAL PAGE SI  DETAIL LOC A - DETAIL N	MUNICIPAL OFFICE  N RD, NOM 2A0  ZE ARCH D - 24" x 36" CATION: O.	
PRO. 2228 COLL COLL COLL COLL COLL COLL COLL COL	Mechanical & Electrical Engineers  London - Windsor - Ottawa  Www.vreng.ca   519-652-5047	MUNICIPAL OFFICE  N RD, NOM 2A0  ZE ARCH D - 24" x 36" CATION: O.	
PRO. 2228 COLL COLL COLL COLL COLL COLL COLL COL	Mechanical & Electrical Engineers  London - Windsor - Ottawa  Www.vreng.ca   519-652-5047	MUNICIPAL OFFICE  N RD, NOM 2A0  ZE ARCH D - 24" x 36" CATION: O.	
PRO. 2228 COLL 10227 ILDER ORIGIN KEY TO	Mechanical & Electrical Engineers  London - Windsor - Ottawa  Www.vreng.ca   519-652-5047	MUNICIPAL OFFICE  N RD, NOM 2A0  ZE ARCH D - 24" x 36"  CATION: O. O. ORIGIN	
PRO. 2228 COLL COLL COLL COLL COLL COLL COLL COL	Mechanical & Electrical Engineers  London - Windsor - Ottawa  Www.vreng.ca   519-652-5047	MUNICIPAL OFFICE  N RD, NOM 2A0  ZE ARCH D - 24" x 36"  CATION: O. O. ORIGIN	
PRO. 2228 COLL COLL COLL COLL COLL COLL COLL COL	Mechanical & Electrical Engineers  London - Windsor - Ottawa  Www.vreng.ca   519-652-5047	MUNICIPAL OFFICE  N RD, NOM 2A0  ZE ARCH D - 24" x 36"  CATION: O. O. ORIGIN	
PRO. 2228 COLL COLL COLL COLL COLL COLL COLL COL	Mechanical & Electrical Engineers  Compon: Windsor: Ottawa  www.vreng.ca   519-652-5047	MUNICIPAL OFFICE  N RD, NOM 2A0  ZE ARCH D - 24" x 36"  CATION: O. O. ORIGIN	
PRO. 2228 COLL COLL COLL COLL COLL COLL COLL COL	Mechanical & Electrical Engineers  London - Windsor - Ottawa  Www.vreng.ca   519-652-5047	MUNICIPAL OFFICE  N RD, NOM 2A0  ZE ARCH D - 24" x 36"  CATION: IO. O. ORIGIN	
PRO. 2228 COLL COLL COLL COLL COLL COLL COLL COL	Mechanical & Electrical Engineers  London - Windsor - Ottawa  Www.vreng.ca   519-652-5047	MUNICIPAL OFFICE  N RD, NOM 2A0  ZE ARCH D - 24" x 36"  CATION: IO. O. ORIGIN	
PRO. 2228 COLL 10227 ILDER ORIGIN KEY TO	Mechanical & Electrical Engineers  London - Windsor - Ottawa  Www.vreng.ca   519-652-5047	MUNICIPAL OFFICE  N RD, NOM 2A0  ZE ARCH D - 24" x 36"  CATION: IO. O. ORIGIN	Z

E1.1.4

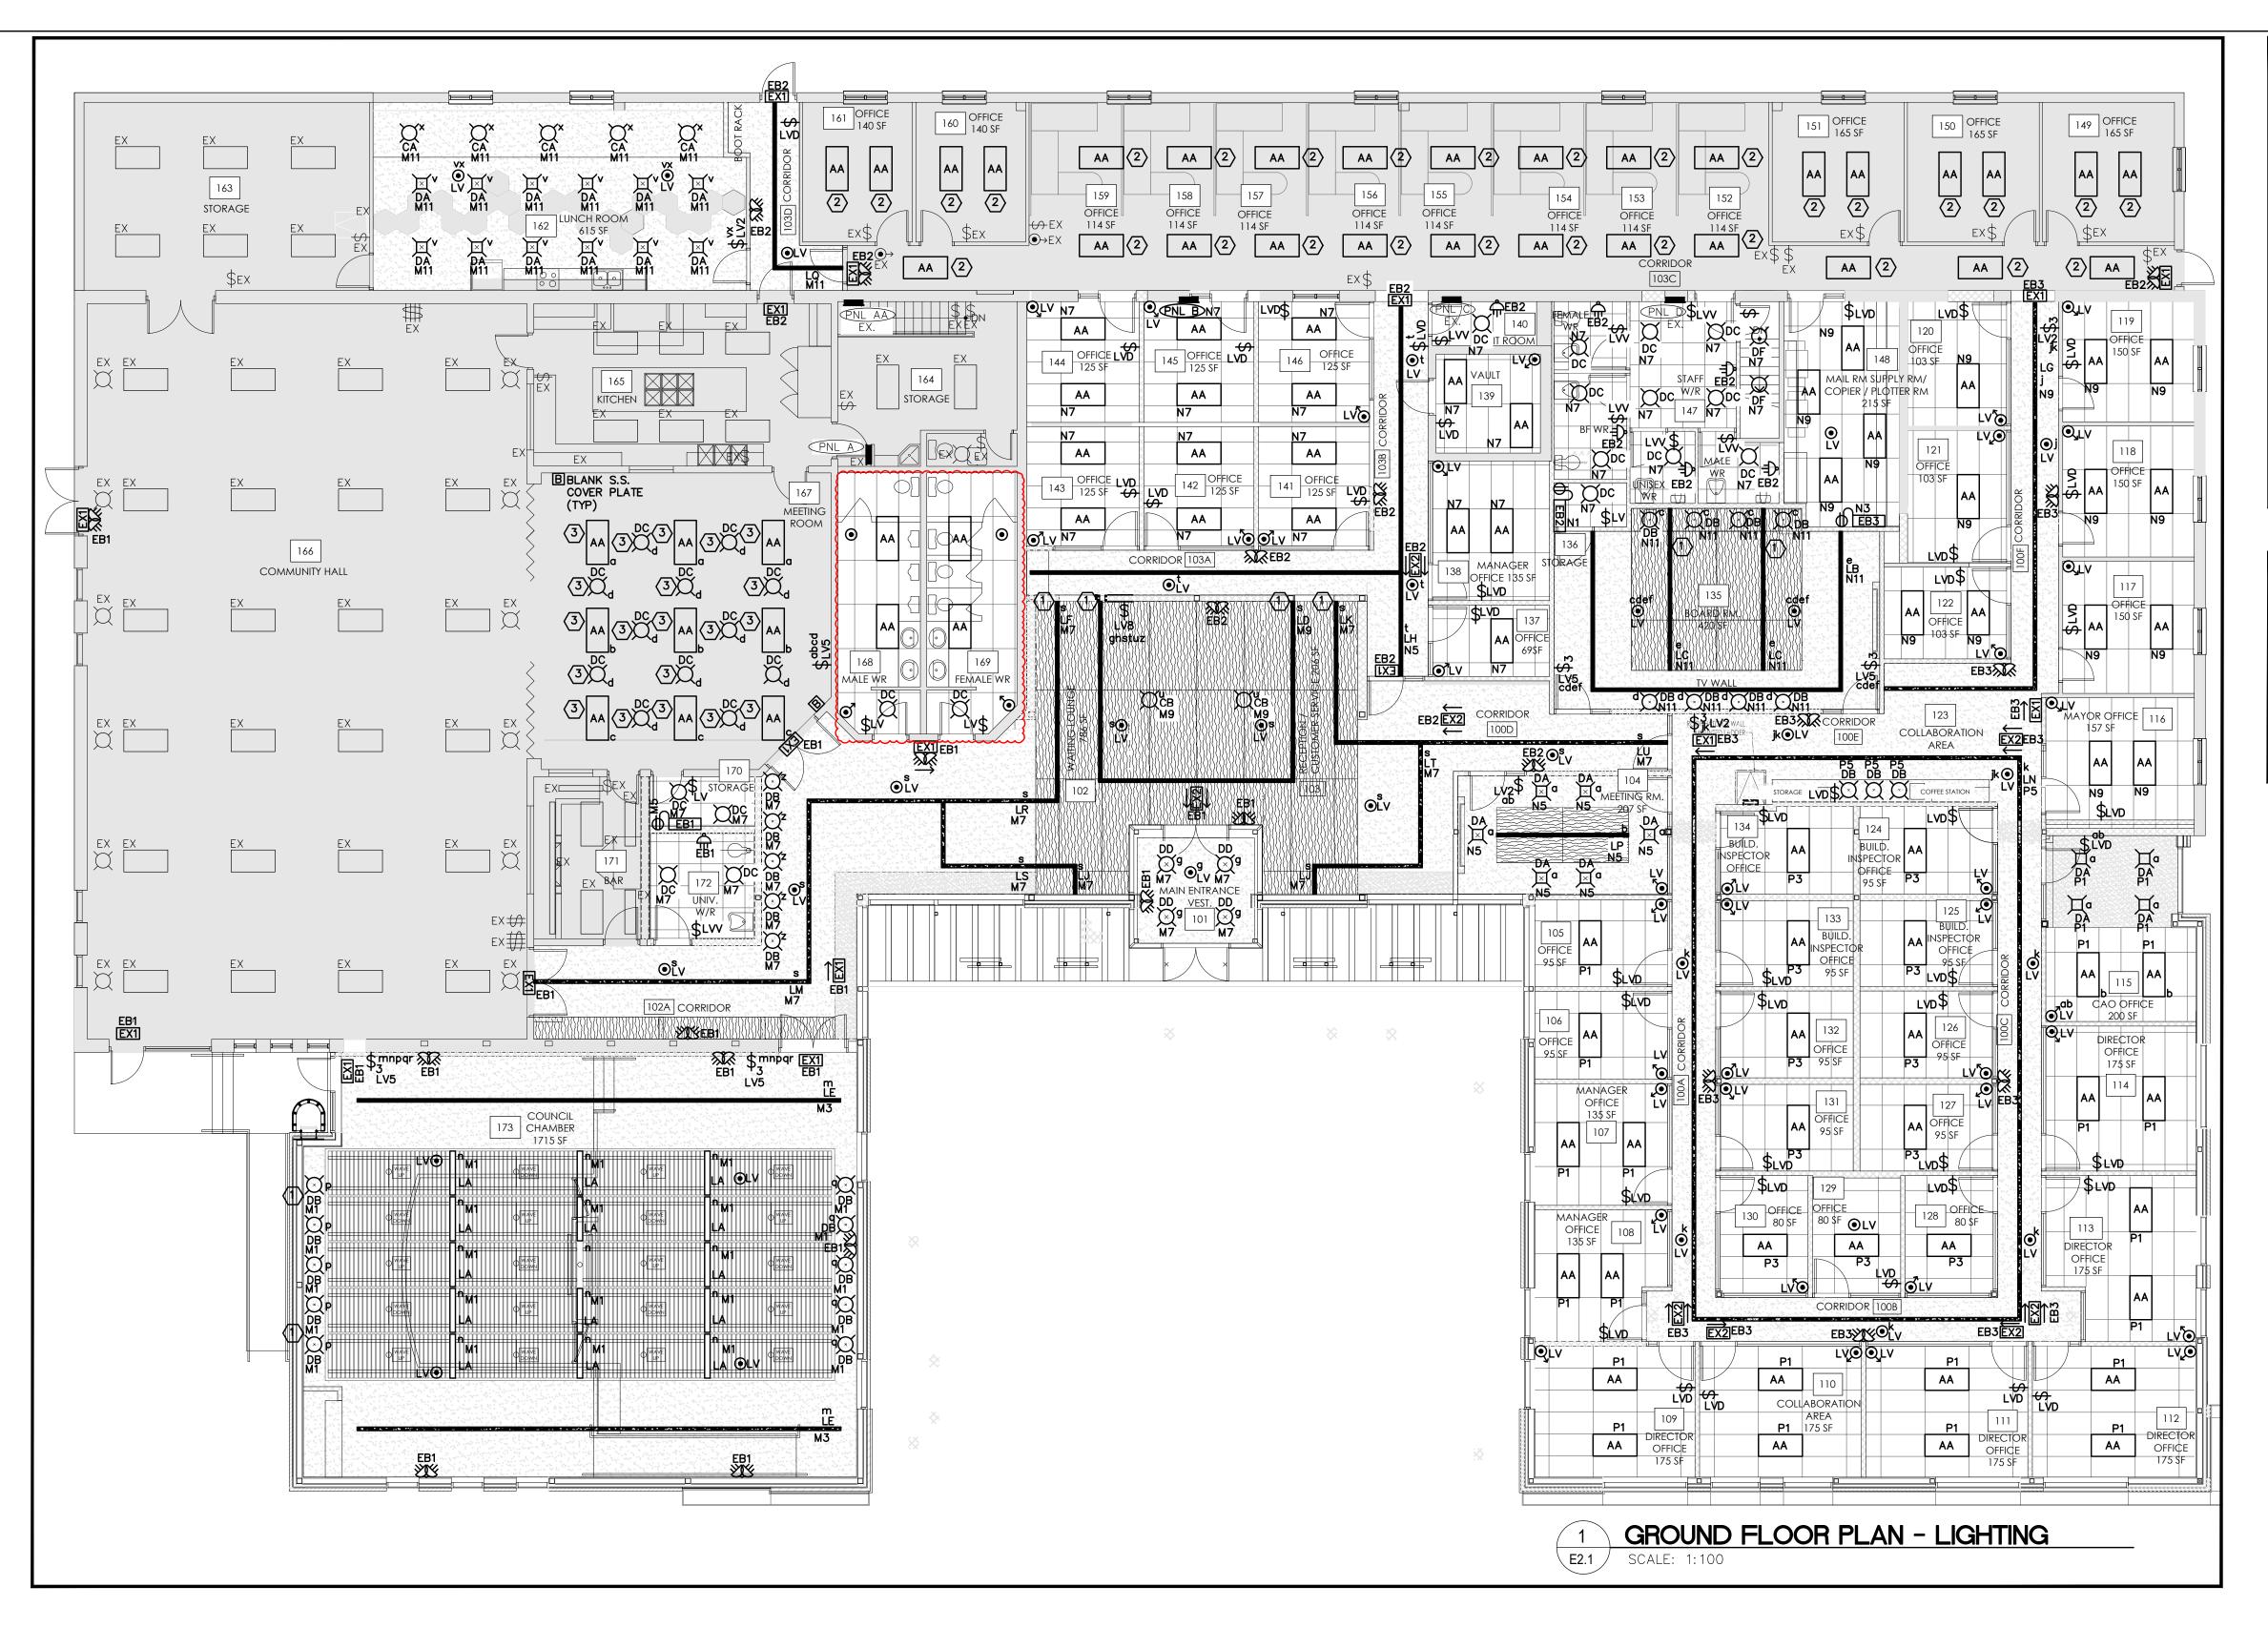

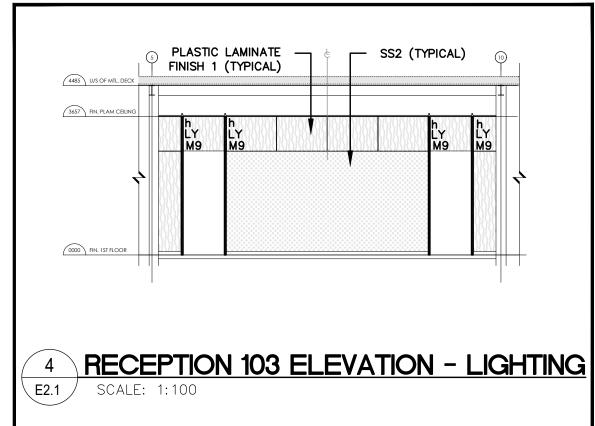

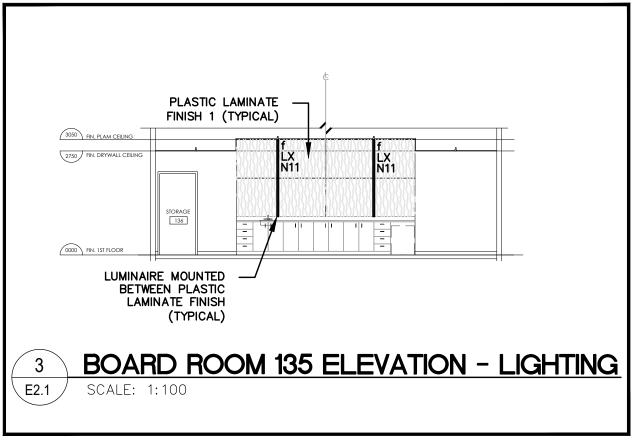

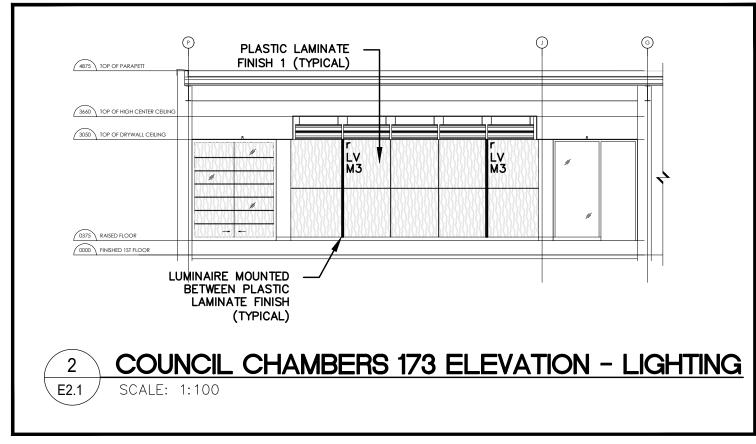

## LIGHTING GENERAL NOTES

- 1. DEVICES/EQUIPMENT/LUMINAIRES TAGGED WITH 'REL' ARE EXISTING TO BE RELOCATED. FOR EACH DEVICE/EQUIPMENT/LUMINAIRE, MODIFY AND EXTEND EXISTING CONDUIT AND WIRING TO NEW LOCATION AS REQUIRED, UNLESS NOTED OTHERWISE.
- 2. DEVICES/EQUIPMENT/LUMINAIRES TAGGED WITH 'REP' ARE EXISTING TO BE REPLACED WITH NEW. FOR EACH DEVICE/EQUIPMENT/LUMINAIRE, PROVIDE REPLACEMENT DEVICE/EQUIPMENT/LUMINAIRE AND RECONNECT WITH NEW WIRING IN CONDUIT. EXISTING CONDUIT MAY BE REUSED TO THE GREATEST EXTENT POSSIBLE.
- DEVICES/EQUIPMENT/LUMINAIRES TAGGED WITH 'REP/REL' ARE EXISTING TO BE REPLACED WITH NEW AND INSTALLED AT A NEW LOCATION. FOR EACH DEVICE/EQUIPMENT/LUMINAIRE, PROVIDE REPLACEMENT DEVICE/EQUIPMENT/LUMINAIRE AND RECONNECT WITH NEW WIRING IN CONDUIT. MODIFY AND EXTEND EXISTING CONDUIT TO NEW LOCATION AS REQUIRED.
- 4. EXISTING DEVICES/EQUIPMENT/LUMINAIRES IN LIGHT LINES TAGGED WITH 'EX' ARE EXISTING TO REMAIN.
- EXISTING FIRE ALARM SYSTEM TO BE MAINTAINED DURING THE ENTIRE DEMOLITION AND CONSTRUCTION PERIOD. FIRE ALARM MODIFICATION AND ADDITION TO BE ACTIVATED AND VERIFIED AS CONSTRUCTION IS COMPLETED.
- 6. COORDINATE EXACT CONDUIT ROUTINGS WITH BUILDING ELEMENTS AND SYSTEMS IN THE FIELD PRIOR TO INSTALLATION. INSTALL CONDUITS PARALLEL TO BUILDING LINES TO THE GREATEST EXTENT POSSIBLE.

## LIGHTING KEY NOTES

- LUMINAIRE SERIES 'L' TO TURN AT 90° AND RUN DOWN WALL. REFER TO ELEVATION ON THIS SHEET.
- DISCONNECT EXISTING RECESSED TROFFER AND REMOVE. PROVIDE NEW FIXTURE TYPE "AA" AND CONNECT TO EXISTING LIGHT CIRCUIT AND LIGHTING CONTROLS
- DISCONNECT EXISTING RECESSED DOWNLIGHT AND TROFFER AND REMOVE. PROVIDE NEW FIXTURE AND LIGHTING CONTROLS, CONNECT FIXTURE TO EXISTING LIGHT CIRCUIT.
- DISCONNECT AND REMOVE EXISTING RED EXIT SIGNS AND ASSOCIATED EMERGENCY HEADS. PROVIDE NEW GREEN RUNNING MAN EXIT SIGNS AND EMERGENCY HEAD AND CONNECT TO EMERGENCY BATTERY CIRCUITS.

10.	DATE	PARTICULAR
1	2023.05.29	ISSUED FOR COSTING
2	2023.08.03	ISSUED FOR TENDER
3	2023.08.15	ISSUED FOR PERMIT
4	2023.09.13	ISSUED FOR IFC
5	2024.03.08	ISSUED FOR CCO-ME-02
6	2024.04.30	ISSUED FOR CCO-ME-03
7	2024.05.08	ISSUED FOR CCO-ME-04
8	2024.08.07	ISSUED FOR SI-ME-03
9	2024.08.28	ISSUED FOR SI-ME-05
10	2024.08.28	ISSUED FOR CCO-ME-09
11	2024.10.01	ISSUED FOR CCO-ME-14

NOTES:

**KEY PLAN:** 

CLIENT:

**PROJECT:** 22281

COLDSTREAM MUNICIPAL OFFICE

COLDSTREAM MUNICIPAL OFFICE

10227 ILDERTON RD,

ILDERTON, ON NOM 2A0


B - DETAIL NO. ORIGIN

ORIGINAL PAGE SIZE ARCH D - 24" x 36"

KEY TO DETAIL LOCATION:

A A - DETAIL NO.


Vanderwesten & Rutherford Associates Inc.
Mechanical & Electrical Engineers
London . Windsor . Ottawa
www.vreng.ca | 519-652-5047

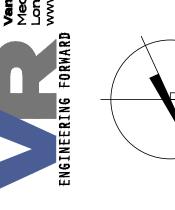



V&R# 23-006

E2.1.7

DRAWN BY: AB CHECKED BY: EC

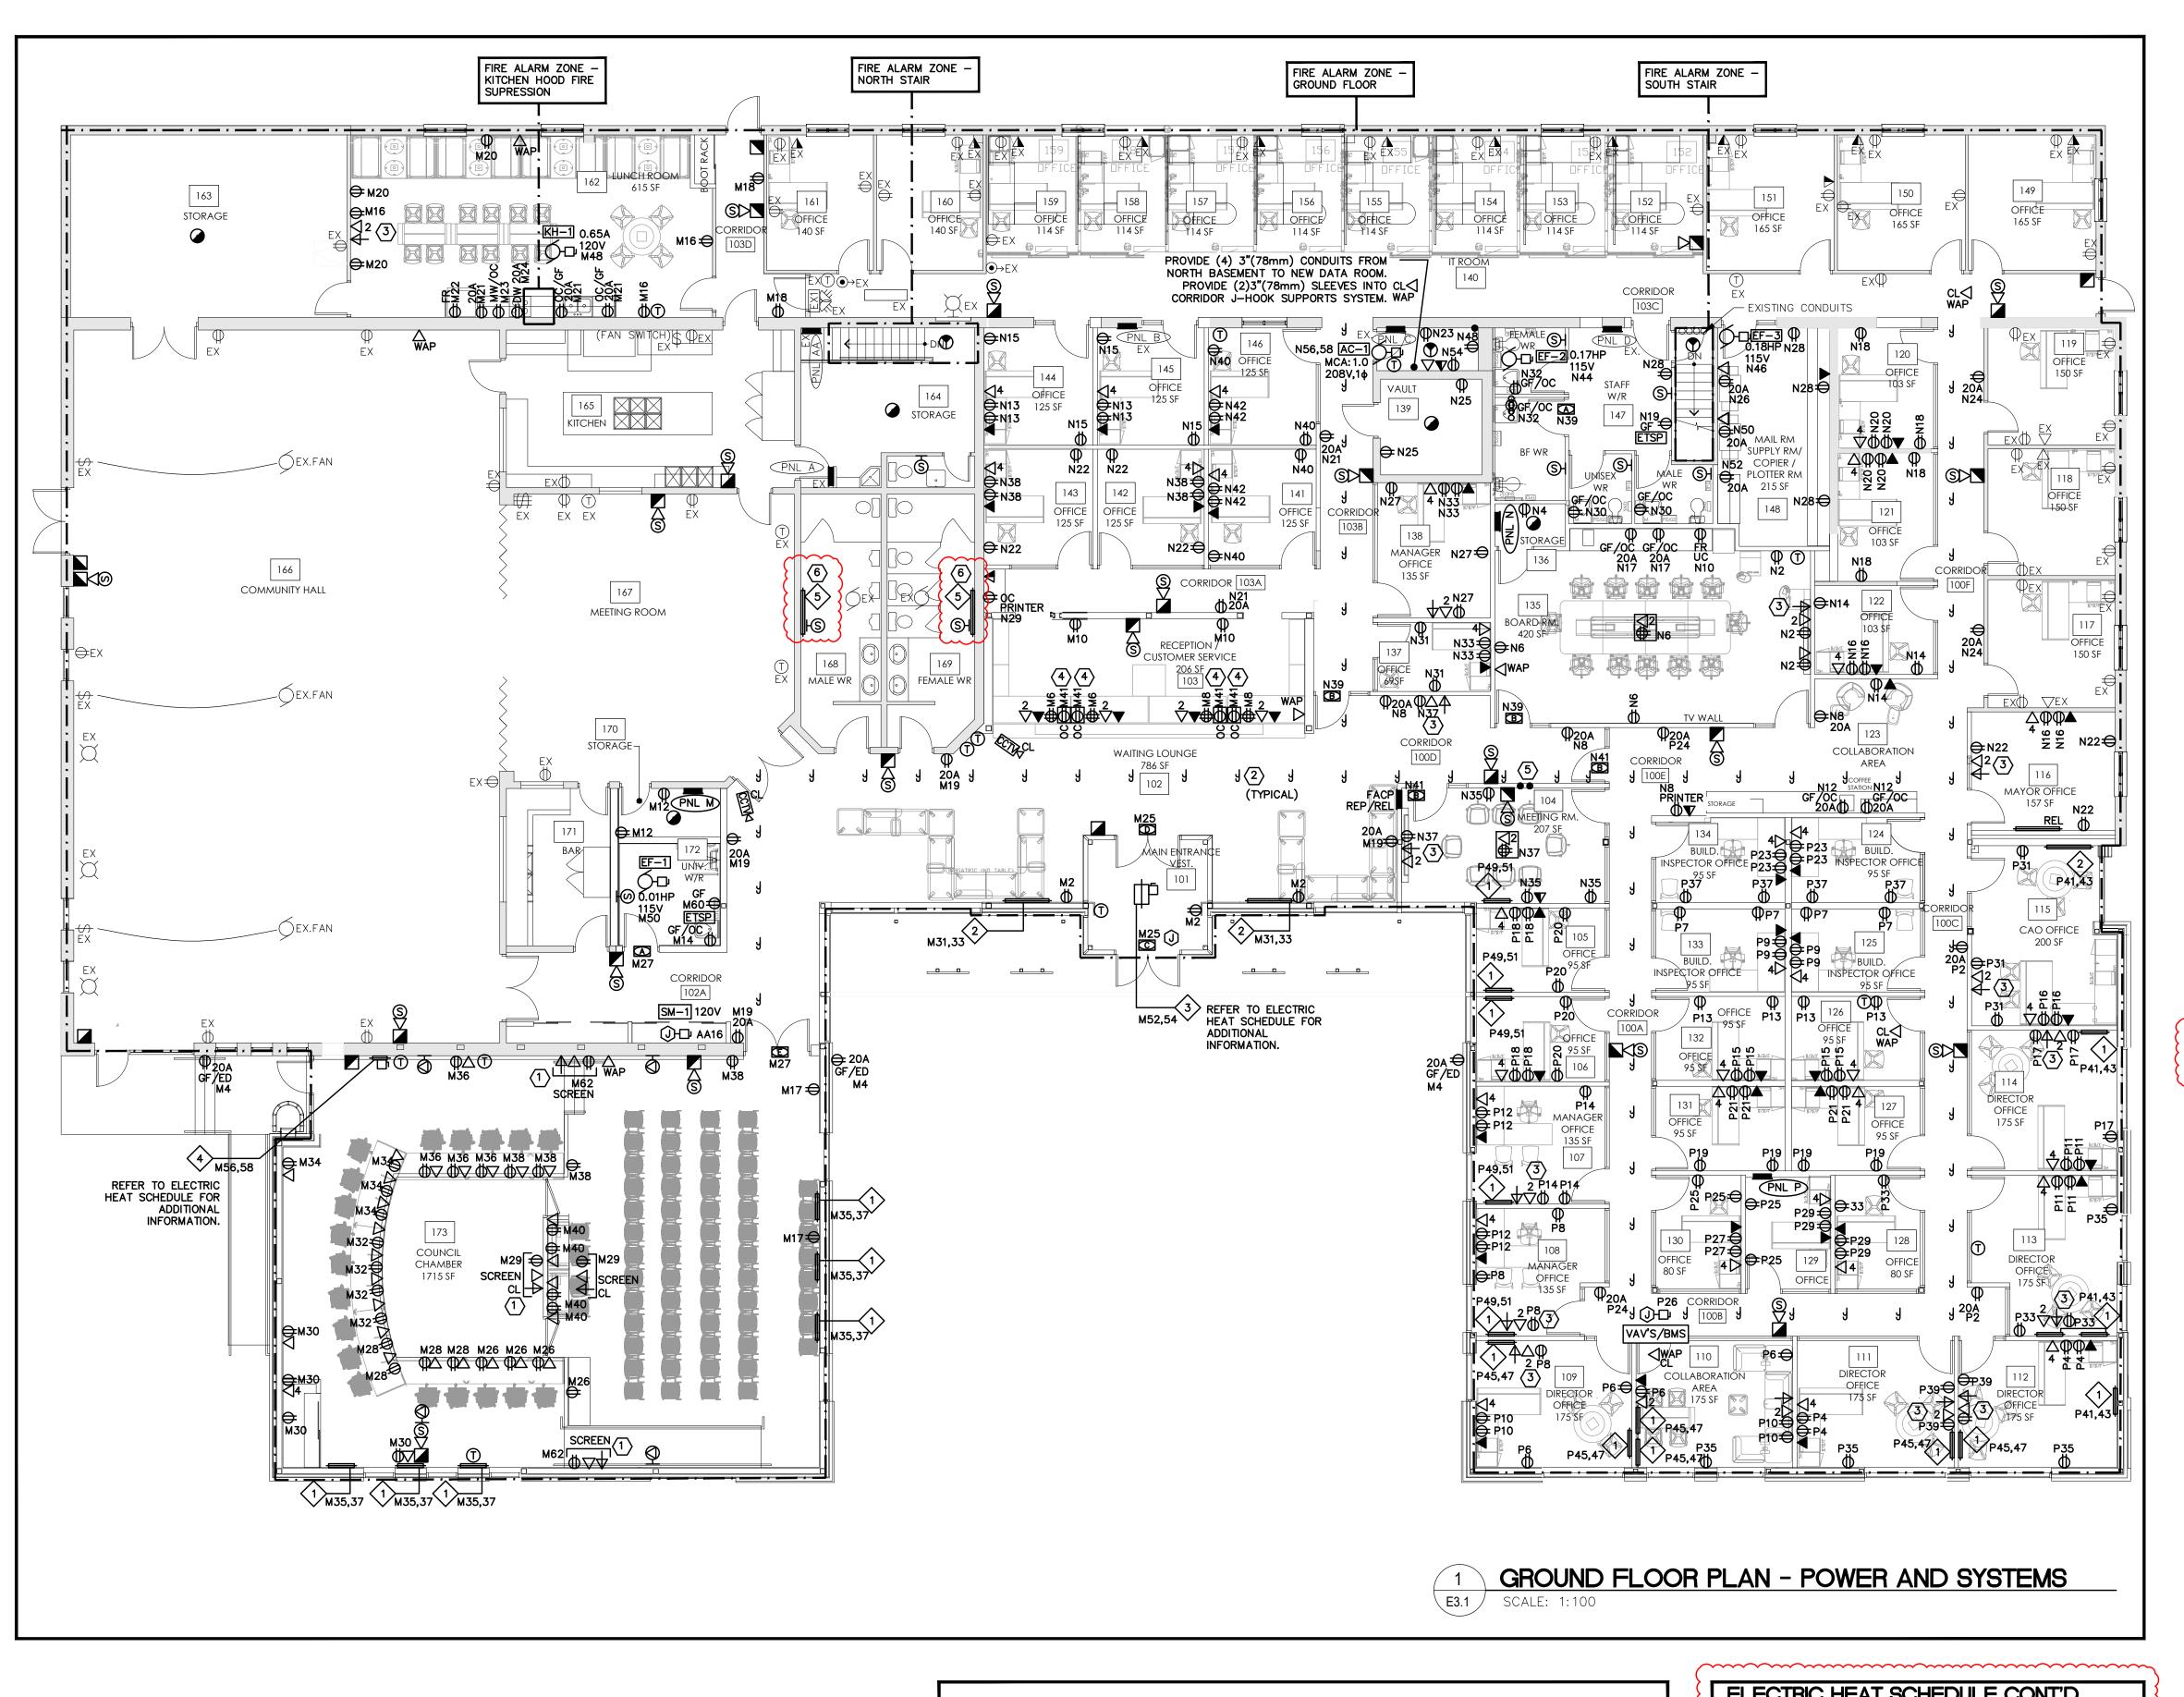

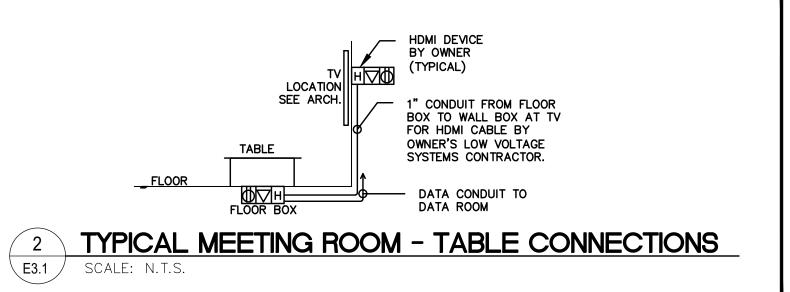

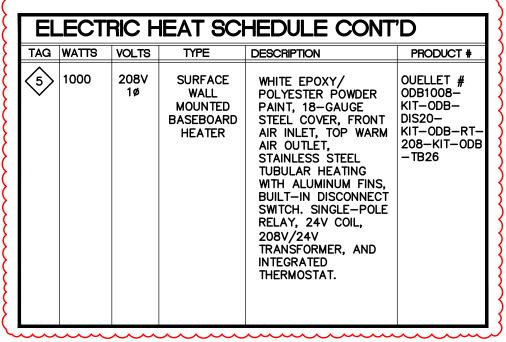

## POWER AND SYSTEMS GENERAL NOTES

- 1. DEVICES/EQUIPMENT/LUMINAIRES TAGGED WITH 'REL' ARE EXISTING
  TO BE RELOCATED. FOR EACH DEVICE/EQUIPMENT/LUMINAIRE,
  MODIFY AND EXTEND EXISTING CONDUIT AND WIRING TO NEW
  LOCATION AS REQUIRED, UNLESS NOTED OTHERWISE.
- DEVICES/EQUIPMENT/LUMINAIRES TAGGED WITH 'REP' ARE EXISTING
  TO BE REPLACED WITH NEW. FOR EACH
  DEVICE/EQUIPMENT/LUMINAIRE, PROVIDE REPLACEMENT
  DEVICE/EQUIPMENT/LUMINAIRE AND RECONNECT WITH NEW WIRING IN
  CONDUIT. EXISTING CONDUIT MAY BE REUSED TO THE GREATEST
  EXTENT POSSIBLE.
- 3. DEVICES/EQUIPMENT/LUMINAIRES TAGGED WITH 'REP/REL' ARE EXISTING TO BE REPLACED WITH NEW AND INSTALLED AT A NEW LOCATION. FOR EACH DEVICE/EQUIPMENT/LUMINAIRE, PROVIDE REPLACEMENT DEVICE/EQUIPMENT/LUMINAIRE AND RECONNECT WITH NEW WIRING IN CONDUIT. MODIFY AND EXTEND EXISTING CONDUIT TO NEW LOCATION AS REQUIRED.
- EXISTING DEVICES/EQUIPMENT/LUMINAIRES IN LIGHT LINES TAGGED WITH 'EX' ARE EXISTING TO REMAIN.
- EXISTING FIRE ALARM SYSTEM TO BE MAINTAINED DURING THE ENTIRE DEMOLITION AND CONSTRUCTION PERIOD. FIRE ALARM MODIFICATION AND ADDITION TO BE ACTIVATED AND VERIFIED AS CONSTRUCTION IS COMPLETED.
- 6. COORDINATE EXACT CONDUIT ROUTINGS WITH BUILDING ELEMENTS AND SYSTEMS IN THE FIELD PRIOR TO INSTALLATION. INSTALL CONDUITS PARALLEL TO BUILDING LINES TO THE GREATEST EXTENT POSSIBLE.

## FIRE ALARM GENERAL NOTES

- 1. ALL SIGNALS SHALL BE HORN/STROBE COMBINATION UNITS.
- 2. ALL EXISTING FIRE ALARM BELLS IN AREAS OUTSIDE RENOVATION/ADDITIONS SHALL BE REPLACED WITH HORNS.
- 3. AT EXISTING FIRE ALARM PANEL, PROVIDE JUNCTION BOX IN CEILING SPACE ABOVE WITH TERMINAL STRIPS TO EXTEND ALL FIRE ALARM WIRING TO NEW CONTROL PANEL LOCATION.
- PROVIDE NEW RECESS TRIM FOR NEW FIRE ALARM CONTROL PANEL.

### POWER AND SYSTEMS KEY NOTES

- 2 REFER TO J-HOOK SUPPORTS SYSTEM DETAIL ON SHEET E5.0 FOR ADDITIONAL INFORMATION.
- RECEPTACLES, DATA & TV OUTLETS TO BE INSTALLED 1200mm (48") A.F.F.
- PROVIDE POP-UP USB RECEPTACLES WITHIN DESKTOP. MODEL HUBBELL WSBUSB2X2AC5BLK. ARCHITECT TO CONFIRM FINISH PRIOR TO ORDERING. COORDINATE EXACT LOCATION WITH FURNITURE
- CONTRACTOR TO INSTALL CONDUITS C/W PULL WIRE IN WALL AT THIS LOCATION DOWN BELOW FLOOR AND OVER TO FLOOR BOX. CONTRACTOR TO PROVIDE RECCESSED FLOOR BOX IN CONCRETE FLOOR C/W QUAD RECEPTACLE AND DATA AND COVER, ARCHITECT TO CONFIRM COVER COLOUR.
- 6 PROVIDE AND INSTALL NEW BASEBOARD HEATER, CONNECT HEATER TO EXISTING ELECTRICAL CIRCUIT.

			HEAT SCI		PROPUST "
TAG	500	208V 1ø	SURFACE WALL MOUNTED BASEBOARD HEATER	WHITE EPOXY/ POLYESTER POWDER PAINT, 18—GAUGE STEEL COVER, FRONT AIR INLET, TOP WARM AIR OUTLET, STAINLESS STEEL TUBULAR HEATING WITH ALUMINUM FINS, BUILT—IN DISCONNECT SWITCH. SINGLE—POLE RELAY, 24V COIL, 208V/24V TRANSFORMER, AND REMOTE THERMOSTAT.MOUNT BOTTOM OF HEATER AT A MINIMUM OF 2" (51mm) A.F.F.	PRODUCT # OUELLET # ODB0508- KIT-ODB- DIS20- KIT-ODB-RT- 208
2	1000	208V 1ø	SURFACE WALL MOUNTED BASEBOARD HEATER	WHITE EPOXY/ POLYESTER POWDER PAINT, 18—GAUGE STEEL COVER, FRONT AIR INLET, TOP WARM AIR OUTLET, STAINLESS STEEL TUBULAR HEATING WITH ALUMINUM FINS, BUILT—IN DISCONNECT SWITCH. SINGLE—POLE RELAY, 24V COIL, 208V/24V TRANSFORMER, AND REMOTE THERMOSTAT.MOUNT BOTTOM OF HEATER AT A MINIMUM OF 2" (51mm) A.F.F.	OUELLET # ODB1008- KIT-ODB- DIS20- KIT-ODB-RT- 208
3	4000	208V 1¢	RECESS CEILING MOUNTED FAN HEATER	WHITE EPOXY/ POLYESTER POWDER PAINT, 18-GAUGE STEEL FRONT COVER, FACTORY-LUBRICATED MOTOR, TUBULAR HEATING ELEMENT WITH FINS, 24V CONTROL RELAY WITH TRANSFORMER, AND REMOTE THERMOSTAT.	OUELLET# OACP4008- KIT-OACP- DIS20-RT-T
4	4000	208V 1¢	SURFACE WALL MOUNTED FAN HEATER	WHITE EPOXY/ POLYESTER POWDER PAINT, 18-GAUGE STEEL FRONT COVER, FACTORY-LUBRICATED MOTOR, TUBULAR	OUELLET# OACU04008 - T-KIT-OAC -BS1-DIS20 -RT


MOTOR, TUBULAR

HEATING ELEMENT

CONTROL RELAY WITH

TRANSFORMER, AND REMOTE THERMOSTAT.

WITH FINS, 24V

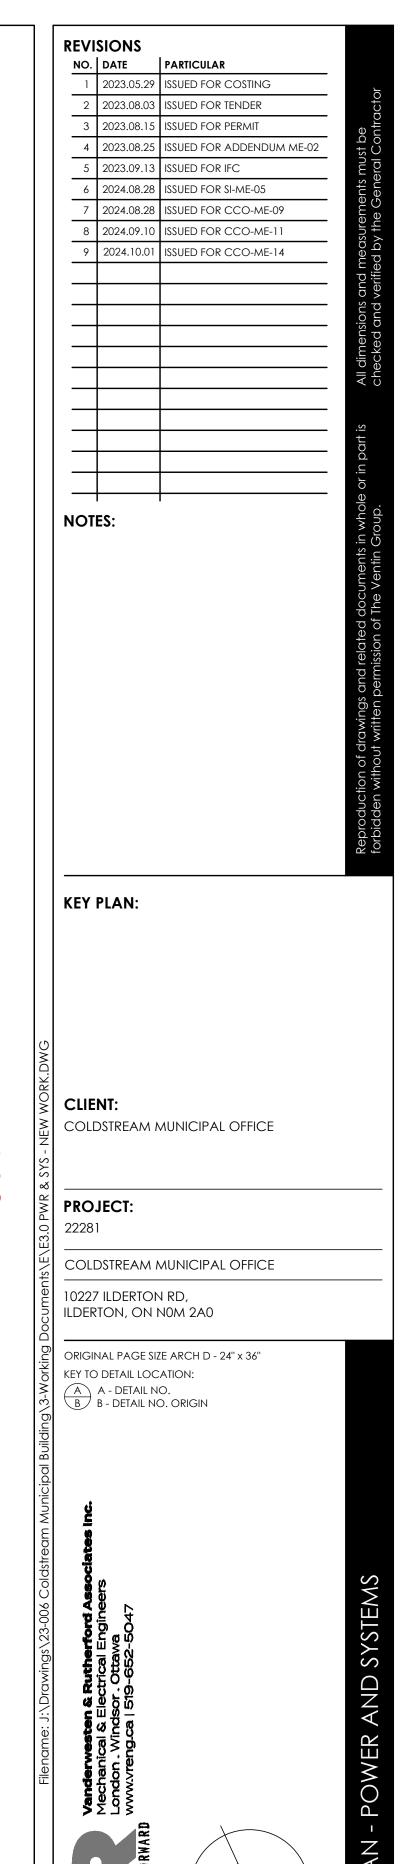

E3.1.4

CHECKED BY: EC

V&R# 23-006

DRAWN BY: AB